

1999

LAND CORNER RECORDATION CERTIFICATE
Filing Requirement of Act 74, Mich. P.A. 1970
Chippewa County Remonumentation Corner

For corners in SECTION

Chippewa Located In: Corner Code #
1. Public Land Survey SAME CORNER T 47N R 1E M-9
T 47N R 2E A-9
2. Property Controlling in Section S T R
3. Miscellaneous Property in Sec. S T R

\$7.00 LAND CORNER
\$2.00 MSSR
21 JAN 1999 10:31:11 AM Receipt #13123
RECEIVED FOR RECORD
CHIPPEWA COUNTY - STATE OF MICHIGAN
SHARON H. KENNEDY, REGISTER OF DEEDS

BOOK 10 PAGE 355
Register of Deeds Stamp & File Number

4. Lot No. Recorded Plat
5. Private Claims

I, Larry R. Rogers, in a field survey on November 09, 1998, do hereby state that under requirements of P.A. 74, Michigan P.A. of 1970, the corner points mentioned in lines 1 and 2 above were in conformance with regulations and rules therefore as required in the current manual of survey instructions of the United States Department of the Interior, Bureau of Land Management or by a decree of a Court of Law and/or that the corner points mentioned in lines 3, 4 and 5 above were in conformance with the rules of the Michigan Board of Land Surveyors or by a Decree of a Court of Law; established, re-established, monumented, recovered, found as expressed below:

NOTE: Not more than 2 corners, all in the same town and range, may be recorded on this certificate.


Grid table with columns A-M and rows 1-13. Contains handwritten numbers and symbols like 'E', 'L', 'N', 'H'.

A. Description of original monument and accessories and/or subsequent restoration:
(M-9) Southeast Corner of Section 24, Township 47 North, Range 1 East.

The original corner was placed in 1845 by John Mullett. In 1927, County Surveyor Colwell refers to Corner as "post in fence" and gives a distance of 2605 feet South to 1/4 Corner. 1935 County Surveyor notes refer to Corner as an iron pipe and oak post and gives a distance of 2616 feet South to 1/4 Corner. In 1981, William L. Karr, P.S. 27450 found 1" iron pipe and 2" x 2" wood post, set plastic cap inside pipe and filed L.C.R.C. in Liber 5, Page 146 of the Chippewa County Corner Records. Distance South to 1/4 Corner, now measuring, 2615.55 feet.

B. Description of corner evidence found and/or method applied in restoring or reestablishing corner:
(M-9) Southeast Corner of Section 24, Township 47 North, Range 1 East.

This corner is being perpetuated as part of the Chippewa County Remonumentation Program. Found a 1" iron pipe with P.S. cap number 27450 and recovered four Karr witnesses - one now dead. Accepted corner position as found.

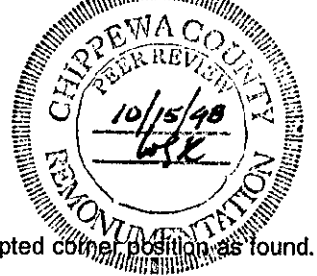

C. Description of monument for corner and accessories established to perpetuate locating the position of the corner:
(M-9) Southeast Corner of Section 24, Township 47 North, Range 1 East.

Corner is a 1" iron pipe with P.S. cap number 27450.

Witnesses table: 16" Ash N37°W 8.84 feet, 6" Oak S11°W 3.00 feet, 5" Ash S37°E 17.35 feet, 8" Ash N46°E 32.90 feet, Steel Fence Post North 2.0 feet



Signed by [Signature] Date 30 DEC 1998

Surveyor's Michigan License No. 29251

NOTE: All bearings are compass bearings corrected for declination (6°W). All distances are to a nail and tag in the side of witness object unless otherwise noted.