

1999

LAND CORNER RECORDATION CERTIFICATE
Filing Requirement of Act 74, Mich. P.A. 1970
Chippewa County Remonumentation Corner

SECTION

For corners in

Chippewa

Located in:

Corner Code #

- 1. Public Land Survey SAME CORNER { T 47N R 1E M-10
T 47N R A-10 A-10
T R
T R
2. Property Controlling in Section S T R
S T R
3. Miscellaneous Property in Sec. S T R
S T R

\$7.00 LAND CORNER
\$2.00 MSSR
21 JAN 1999 10:31:54 AM Receipt #13123
RECEIVED FOR RECORD
CHIPPEWA COUNTY - STATE OF MICHIGAN
SHARON H. KENNEDY, REGISTER OF DEEDS

BOOK 10 PAGE 356
Register of Deeds Stamp & File Number


- 4. Lot No. Recorded Plat
5. Private Claims

I, Larry R. Rogers, in a field survey on December 22, 1998, do hereby state that under requirements of P.A. 74, Michigan P.A. of 1970, the corner points mentioned in lines 1 and 2 above were in conformance with regulations and rules therefore as required in the current manual of survey instructions of the United States Department of the Interior, Bureau of Land Management or by a decree of a Court of Law and/or that the corner points mentioned in lines 3, 4 and 5 above were in conformance with the rules of the Michigan Board of Land Surveyors or by a Decree of a Court of Law; established, re-established, monumented, recovered, found as expressed below:

NOTE: Not more than 2 corners, all in the same town and range, may be recorded on this certificate.

Grid table with columns A-M and rows 1-13. Contains handwritten numbers and symbols.

A. Description of original monument and accessories and/or subsequent restoration: (M-10) East 1/4 Corner of Section 25, Township 47 North, Range 1 East. The original corner was placed in 1845 by John Mullett. In 1927, County Surveyor Colwell said "1/4 post gone" and "blazed fence post." 1935 County Surveyor notes give two witnesses to corner, but do not describe the corner.

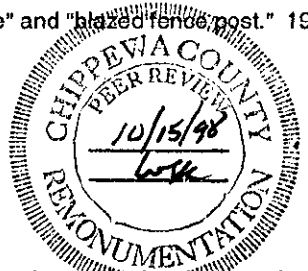

B. Description of corner evidence found and/or method applied in restoring or reestablishing corner: (M-10) East 1/4 Corner of Section 25, Township 47 North, Range 1 East. This corner is being perpetuated as part of the Chippewa County Remonumentation Program. Found no evidence of original corner position or subsequent County Surveyor witnesses. Found 4" diameter concrete monument with "Chippewa County" brass cap. Distance to Northeast Corner of Section 25 is 2615.55 feet (County Surveyor 2616 feet) and distance to Southeast Corner of Section 25 is 2620.85 feet (County Surveyor 2616 feet). Monument is 65 feet East of a straight line between Northeast and Southeast corners of Section 25. Accepted Corner position as found.

C. Description of monument for corner and accessories established to perpetuate locating the position of the corner: (M-10) East 1/4 Corner of Section 25, Township 47 North, Range 1 East. Corner is a "Chippewa County" 4" inch diameter concrete monument with stamped brass cap.



- Witnesses:
6" Oak N80°W 10.78 feet
8" Aspen N54°E 15.97 feet
4" Maple S06°E 17.61 feet
10" Aspen S30°W 19.70 feet
Steel Fence Post North 2.0 feet

Signed by [Signature] Date 30 DEC 1998

Surveyor's Michigan License No. 29251

NOTE: All bearings are compass bearings corrected for declination (6°W). All distances are to a nail and tag in the side of witness object unless otherwise noted.

FORM APPROVED BY MICHIGAN STATE BOARD OF PROFESSIONAL SURVEYORS, JAN. 28, 1971
REVISED MAY 14, 1975
REVISED JAN., 1983
REVISED OCT., 1995