

SECTION

LAND CORNER RECORDATION CERTIFICATE
Filing Requirement of Act 74, Mich. P.A. 1970
Chippewa County Remonumentation Corner


For corners in

Table with columns: Chippewa County, Located in:, Corner Code #. Rows include Public Land Survey, Property Controlling in Section, Miscellaneous Property in Sec., Lot No., and Private Claims.

BOOK 11 PAGE 96

\$7.00 LAND CORNER
\$2.00 MSSR
23 FEB 2000 3:59:34 PM Receipt #21174
RECEIVED FOR RECORD
CHIPPEWA COUNTY - STATE OF MICHIGAN
SHARON H. KENNEDY, REGISTER OF DEEDS
Register of Deeds Stamp & File Number

I, William L. Karr, in a field survey on December 22, 1999, do hereby state that under requirements of P.A. 74, Michigan P.A. of 1970, the corner points mentioned in lines 1 and 2 above were in conformance with regulations and rules therefore as required in the current manual of survey instructions of the United States Department of the Interior, Bureau of Land Management or by a decree of a Court of Law and for that the corner points mentioned in lines 3, 4 and 5 above were in conformance with the rules of the Michigan Board of Land Surveyors or by a Decree of a Court of Law; established, re-established, monumented, recovered, found as expressed below:

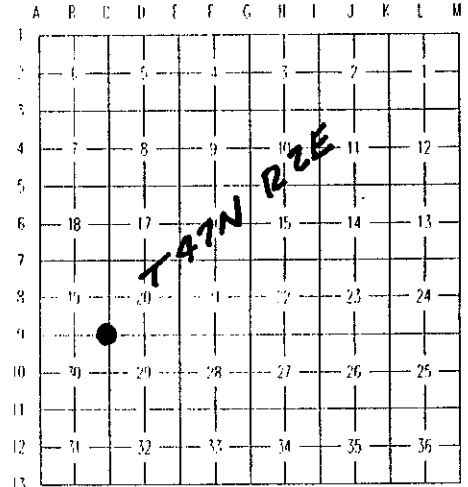

NOTE: Not more than 2 corners, all in the same town and range, may be recorded on this certificate.

A. Description of original monument and accessories and/or subsequent restoration:

(C-9) Section Corner Common to Sections 19, 20 29 and 30, Township 47 North, Range 2 East.

1845 John H. Mullett set post. Witnesses: Maple 10 S65°E 22
Fir 8 N15°E 16

Early 1900's Appears that Brown ran a random line between 29 and 30 and measured the mile at 5217. (C-9) is mentioned as a U.S. corner.

Early 1900's Appears that Chas Thompson ran a random line between 29 and 30 and measured mile at 5117 feet.

1938 Colwell set 1" pipe and oak post.

1994 William L. Karr, P.S. 27450 re-established corner position based on Colwell survey of 1938.

B. Description of corner evidence found and/or method applied in restoring or reestablishing corner:

(C-9) Section Corner Common to Sections 19, 20 29 and 30, Township 47 North, Range 2 East.

This corner is being perpetuated as part of the Chippewa County Remonumentation Program.

Found no evidence of the original corner. Found 3/4" iron as re-established in 1994. Distance South is 5167.00 (m) distance East is 5196.22 (m) 5198 feet (Colwell). No distance to the West to compare to. 5247.40 (m) 1/4 line fence in Section 20 to the North measures 2639.84 feet. Accepted corner position as found.

C. Description of monument for corner and accessories established to perpetuate locating the position of the corner:

(C-9) Section Corner Common to Sections 19, 20 29 and 30, Township 47 North, Range 2 East.

Corner is a 3/4" x 24" iron with plastic Chippewa County Remonumentation Corner cap 5" below grade. Corner falls on centerline of Homestead Road and 25 feet North of centerline of 4 Mile Road.

Witnesses:
Power Pole SUI/27/93 N84°E 28.94 feet (existing)
Power Pole S17°E 69.01 feet (existing)
Maple 14" S48°W 51.51 feet (existing)
Power Pole N73°W 29.71 feet (existing)



Bearings are compass bearings, corrected for declination (7°W), all distances are to a nail and tap in the side of the witness object unless otherwise noted.

BOOK 11 PAGE 96

Signed by [Signature]

Date 12-25-99

Surveyor's Michigan License No. 27450

