

RECORDED
1999

DEC 1 1999

LAND CORNER RECORDATION CERTIFICATE

Filing Requirement of Act 74, Mich. P.A. 1970
Chippewa County Remonumentation Corner

For corners in SECTION

Chippewa	Located In:	Corner Code #
1. Public Land Survey	SAME CORNER { T 47N R 2E T 48N R 2E T ___ R ___ T ___ R ___	D-1 ✓ D-13
2. Property Controlling in Section	S ___ T ___ R ___ S ___ T ___ R ___	
3. Miscellaneous Property in Sec.	S ___ T ___ R ___ S ___ T ___ R ___	

\$7.00 LAND CORNER
\$2.00 MSSR
21 JAN 1999 11:12:28 AM Receipt #13123
RECEIVED FOR RECORD
CHIPPEWA COUNTY - STATE OF MICHIGAN
SHARON H. KENNEDY, REGISTER OF DEEDS

BOOK 10 PAGE 380
Register of Deeds Stamp & File Number


4. Lot No. _____, Recorded Plat _____
5. Private Claims _____

I, Larry R. Rogers, in a field survey on November 11, 1998, do hereby state that under requirements of P.A. 74, Michigan P.A. of 1970, the corner points mentioned in lines 1 and 2 above were in conformance with regulations and rules therefore as required in the current manual of survey instructions of the United States Department of the Interior, Bureau of Land Management or by a decree of a Court of Law and/or that the corner points mentioned in lines 3, 4 and 5 above were in conformance with the rules of the Michigan Board of Land Surveyors or by a Decree of a Court of Law; established, re-established, monumented, recovered, found as expressed below:

1	A	B	C	D	E	F	G	H	I	J	K	L	M
2		6		5		4		3		2		1	
3													
4		7		8		9		10		11		12	
5													
6		18		17		16		15		14		13	
7													
8		19		20		21		22		23		24	
9													
10		30		29		28		27		26		25	
11													
12		31		32		33		34		35		36	
13													

NOTE: Not more than 2 corners, all in the same town and range, may be recorded on this certificate.

A. Description of original monument and accessories and/or subsequent restoration:
(D-1) North 1/4 corner of Section 5, Township 47 North, Range 2 East.
The original corner was placed in 1842 by John Mullett. In 1919 and 1927 County Surveyor notes give distance of 2585 feet to Northwest corner of Section 5 and also references fences to North and South.

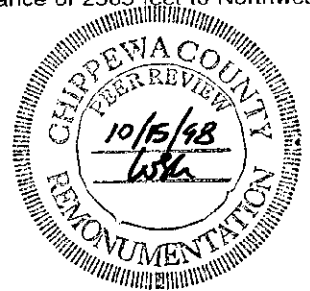

B. Description of corner evidence found and/or method applied in restoring or reestablishing corner:
(D-1) North 1/4 corner of Section 5, Township 47 North, Range 2 East.
This corner is being perpetuated as part of the Chippewa County Remonumentation Program. Found evidence of original corner position. Found remains of old fences to North and South. Re-established corner position on line with old fences North and South and 33.0 feet South of the end fence post to North. Distance to Northwest corner of Section 5 is 2583.08 feet (County Surveyor 2585)

C. Description of monument for corner and accessories established to perpetuate locating the position of the corner:
(D-1) North 1/4 corner of Section 5, Township 47 North, Range 2 East.
Corner is a 3/4" x 24" rered with plastic remonumentation cap, 4" below grade of East-West gravel road, 4 feet North of centerline of said road and on the extension of fences to North and South.

Witnesses:

- 8" White Pine N77°E 90.53 feet
- 3/4" capped pipe S70°W 59.21 feet
- 3/4" capped pipe N46°W 41.77 feet
- 3/4" capped pipe S40°E 46.51 feet



Signed by [Signature] Date 30 DEC 1998

Surveyor's Michigan License No. 29251
NOTE: All bearings are magnetic compass bearings. All distances are to a nail and tag in the side of witness object unless otherwise noted.