

FEB 18 1999

**LAND CORNER RECORDATION CERTIFICATE**

Filing Requirement of Act 74, Mich. P.A. 1970

Chippewa County Remonumentation Corner

\$7.00 LAND CORNER

\$2.00 NSSR

21 JAN 1999 10:35:36 AM Receipt #1312

RECEIVED FOR RECORD

CHIPPEWA COUNTY - STATE OF MICHIGAN  
SHARON H. KENNEDY, REGISTER OF DEEDS

For corners in

SECTION

Chippewa

Located In:

Corner Code #

1. Public Land Survey

SAME CORNER { T 47N R 2E  
T 48N R 2E

E-1 ✓  
E-13

2. Property Controlling in Section

S T R

3. Miscellaneous Property in Sec.

S T R

4. Lot No. \_\_\_\_\_, Recorded Plat \_\_\_\_\_


5. Private Claims \_\_\_\_\_

BOOK 10 PAGE 361

Register of Deeds Stamp & File Number

I, Larry R. Rogers, in a field survey on November 13, 1998, do hereby state that under requirements of P.A. 74, Michigan P.A. of 1970, the corner points mentioned in lines 1 and 2 above were in conformance with regulations and rules therefore as required in the current manual of survey instructions of the United States Department of the Interior, Bureau of Land Management or by a decree of a Court of Law and/or that the corner points mentioned in lines 3, 4 and 5 above were in conformance with the rules of the Michigan Board of Land Surveyors or by a Decree of a Court of Law; established, re-established, monumented, recovered, found as expressed below:

NOTE: Not more than 2 corners, all in the same town and range, may be recorded on this certificate.

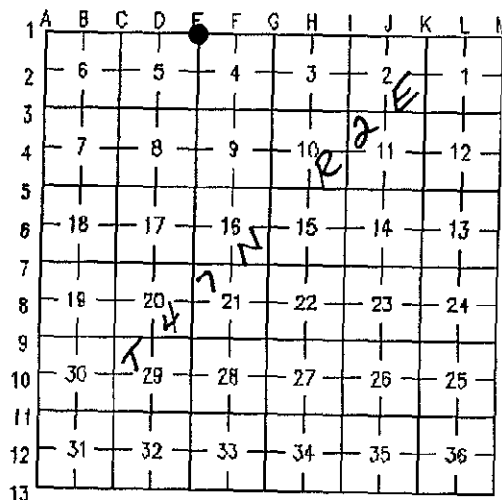

A. Description of original monument and accessories and/or subsequent restoration:

(E-1) Northeast corner of Section 5, Township 47 North, Range 2 East.

Original corner was placed in 1842 by John Mullett. 1920 and 1927 County Surveyor notes refer to original bearing trees and reach distance of 2585 feet West to 1/4 corner. Subsequent County Surveyor notes refer to corner as "wire bolt 1" x 36" " with a 3/4" x 24" iron with stamped aluminum cap set flush with ground.

B. Description of corner evidence found and/or method applied in restoring or reestablishing corner:

(E-1) Northeast corner of Section 5, Township 47 North, Range 2 East.

This corner is being perpetuated as part of the Chippewa County Remonumentation Program.

Found no evidence of corner or witnesses (including 3' x 3' stone). Re-established corner position on line between North 1/4 corner of Section 5 and Northeast corner of Section 4, at County Surveyor distance (2585 feet) East of North 1/4 corner of Section 5. Corner falls 20 feet West of extension of centerline of road to North and on extension of centerline of road to West. New corner falls 19.40 feet West of 1/2" iron pin that appears to have been set at the intersection of road centerlines extended from West and North.


C. Description of monument for corner and accessories established to perpetuate locating the position of the corner:

(E-1) Northeast corner of Section 5, Township 47 North, Range 2 East.

Corner is a 3/4" x 24" iron with stamped aluminum cap set flush with ground.

Witnesses:

4" Spruce	N61°E	70.94 feet
5" Oak	N31°W	47.14 feet
10" Maple	S20°W	34.46 feet
8" Yellow Birch	S45°E	28.67 feet

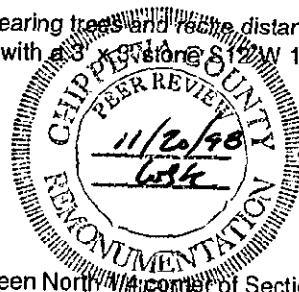

Signed by [Signature] Date 30 DEC 1998

Surveyor's Michigan License No. 29251

NOTE: All bearings are compass bearings corrected for declination (6°W). All distances are to a nail and tag in the side of witness object unless otherwise noted.