

SURVEY & REMONUMENTATION

CHIPPEWA COUNTY REMONUMENTATION CORNER

APR 27 1995

LAND CORNER RECORDATION CERTIFICATE

Filing Requirement of Act 74, Mich. P.A. 1970

For corners of **COMMISSION**
Chippewa

(County)

Located In:

Corner Code #

- | | | |
|------------------------------------|--------------------------|-------------|
| 1. Public Land Survey | T <u>47N</u> R <u>2E</u> | <u>E-11</u> |
| | T _____ R _____ | _____ |
| | T _____ R _____ | _____ |
| | T _____ R _____ | _____ |
| 2. Property Controlling in Section | S _____ T _____ R _____ | _____ |
| | S _____ T _____ R _____ | _____ |
| 3. Miscellaneous Property in Sec. | S _____ T _____ R _____ | _____ |
| | S _____ T _____ R _____ | _____ |

\$ 7.00 LAND CORNER
\$ 2.00 MSSR
24 OCT 94 3:43 P.M. RECEIPT# 831
RECEIVED FOR RECORD
CHIPPEWA COUNTY - STATE OF MICHIGAN
SHARON H. KENNEDY, REGISTER OF DEEDS

Register of Deeds Stamp & File Number

4. Lot No. _____, Recorded Plat _____
5. Private Claims _____

I, Keith R. Waters in a field survey on November 8, 19 93, do hereby certify that under requirements of P.A. 74, Michigan P.A. of 1970, the cornerpoints mentioned in lines 1 and 2 above were in conformance with regulations and rules therefore as required in the current manual of survey instructions of the United States Department of the Interior, Bureau of Land Management or by a decree of a Court of Law and/or that the corner points mentioned in lines 3, 4 and 5 above were in conformance with the rules of the Michigan Board of Land Surveyors or by a Decree of a Court of Law; established, re-established, monumented, re-monumented, recovered, found as expressed below:

NOTE: Not more than 4 corners, all in the same town and range, may be recorded on this certificate.

A. Description of original monument and accessories and/or subsequent restoration:

E-11 Corner Common to Sections 28, 29, 32, & 33, T47N, R2E

Original ties to post: Sugar 6, N38°W 14 links
Sugar 8, S31°E 12 links

Old notes (date unknown) in County Surveyor's office show the following ties to corner: 9" Yellow Birch, N18°E 6' 8" Maple, N70°E 13'
11" Yellow Birch, S10°E 4.5'

B. Description of corner evidence found and/or method applied in restoring or reestablishing corner:

E-11 (T47N, R2E)

This corner is being perpetuated as part of the Chippewa County Remonumentation Program.

Found a squared and scribed wood post and several blazed trees facing post. Found no evidence of original or subsequent accessories. Position works well with found monumentation in Section 28. Accepted position as best available evidence of corner location. Removed wood post and set a 3/4" rebar with a 3 1/4" aluminum Chippewa County Remonumentation cap in center of base. Replaced wood post next to iron.

C. Description of monument for corner and accessories established to perpetuate locating the position of the corner:


E-11 (T47N, R2E)

Corner is a 3/4" x 24" rebar with 3 1/4" aluminum Chippewa County Remonumentation cap. Witnesses:

- 12" Sugar Maple, S75°E 28.48'
- 12" Sugar Maple, S05°E 5.27'
- 14" Sugar Maple, S60°W 15.88'
- 12" Sugar Maple, NORTH 7.62'

Note: Distances are to a nail and tag in the side of the tree. Trees are blazed painted. Bearings are compass bearings corrected for declination.

	A	B	C	D	E	F	G	H	I	J	K	L	M
2	6	5	4	3	2	1							
3													
4	7	8	9	10	11	12							
5													
6	18	17	16	15	14	13							
7													
8	19	20	21	22	23	24							
9													
10	30	29	28	27	26	25							
11													
12	31	32											
13													

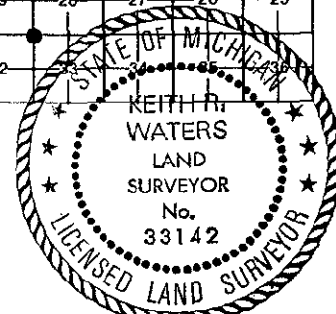

Signed by Keith R. Waters

Date 10-18-94

Surveyor's Michigan License No. 33142

