

1999

LAND CORNER RECORDATION CERTIFICATE
Filing Requirement of Act 74, Mich. P.A. 1970
Chippewa County Remonumentation Corner

SECTION

For corners in

Chippewa

Located In:

Corner Code #

- 1. Public Land Survey SAME CORNER { T 47N R 2E T 48N R 2E
2. Property Controlling in Section S T R
3. Miscellaneous Property in Sec. S T R

F-1 F-13


\$7.00 LAND CORNER \$2.00 HSSR 21 JAN 1999 10:36:13 AM Receipt #13123 RECEIVED FOR RECORD CHIPPEWA COUNTY - STATE OF MICHIGAN SHARON H. KENNEDY, REGISTER OF DEEDS

BOOK 10 PAGE 362

Register of Deeds Stamp & File Number

- 4. Lot No. Recorded Plat
5. Private Claims

I, Larry R. Rogers, in a field survey on November 13, 1998, do hereby state that under requirements of P.A. 74, Michigan P.A. of 1970, the corner points mentioned in lines 1 and 2 above were in conformance with regulations and rules therefore as required in the current manual of survey instructions of the United States Department of the Interior, Bureau of Land Management or by a decree of a Court of Law and/or that the corner points mentioned in lines 3, 4 and 5 above were in conformance with the rules of the Michigan Board of Land Surveyors or by a Decree of a Court of Law; established, re-established, monumented, recovered, found as expressed below:

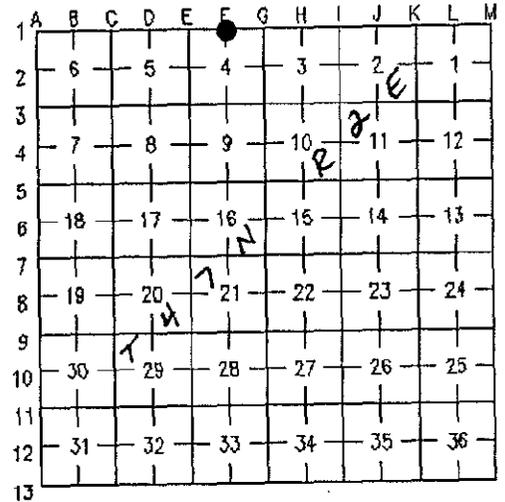

NOTE: Not more than 2 corners, all in the same town and range, may be recorded on this certificate.

A. Description of original monument and accessories and/or subsequent restoration:

(F-1) North 1/4 corner of Section 4, Township 47 North, Range 2 East.

Original corner was placed in 1842 by John Mullett. Found no reference to this corner in County Surveyor notes.



B. Description of corner evidence found and/or method applied in restoring or reestablishing corner:

(F-1) North 1/4 corner of Section 4, Township 47 North, Range 2 East.

This corner is being perpetuated as part of the Chippewa County Remonumentation Program.

Found no evidence of original corner position. Re-established corner position midway and on line between Northwest and Northeast corner of Section 4. Found 3/4" iron pipe 37 feet North of set corner but found no history of corner.


C. Description of monument for corner and accessories established to perpetuate locating the position of the corner:

(F-1) North 1/4 corner of Section 4, Township 47 North, Range 2 East.

Corner is a 3/4" x 24" iron with stamped aluminum cap set 2" above grade and 15 feet South centerline of East-West two track road.

Witnesses:

Table with 3 columns: Witness, Bearing, Distance. Includes Steel Fence Post, 8" Maple, 3/4" iron pipe, 14" Maple, 16" Yellow Birch, 12" Maple.

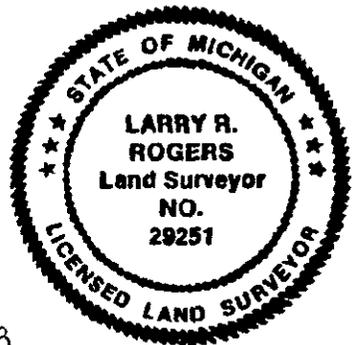

Signed by [Signature]

Date 30 DEC 1998

Surveyor's Michigan License No. 29251

NOTE: All bearings are compass bearings corrected for declination (6'W). All distances are to a nail and tag in the side of witness object unless otherwise noted.