

DEC 07 1994

COMMISSION

For corners in
Chippewa

(County)

Chippewa County Remonumentation Corner

LAND CORNER RECORDATION CERTIFICATE

Filing Requirement of Act 74, Mich. P.A. 1970 7.00 LAND CORNER

\$ 2.00 MSSR

18 OCT 94 1:05 P.M. RECEIPT# 700

RECEIVED FOR RECORD

CHIPPewa COUNTY - STATE OF MICHIGAN
SHARON H. KENNEDY, REGISTER OF DEEDS

1. Public Land Survey	T	<u>47N</u>	R	<u>2E</u>	<u>F-9</u>
	T		R		
	T		R		
	T		R		
2. Property Controlling in Section	S		T		R
	S		T		R
3. Miscellaneous Property in Sec.	S		T		R
	S		T		R

Register of Deeds Stamp & File Number

4. Lot No. _____, Recorded Plat _____
5. Private Claims _____

I, William L. Karr, in a field survey on May 3, 19 93, do hereby certify that under requirements of P.A. 74, Michigan P.A. of 1970, the corner points mentioned in lines 1 and 2 above were in conformance with regulations and rules therefore as required in the current manual of survey instructions of the United States Department of the Interior, Bureau of Land Management or by a decree of a Court of Law and/or that the corner points mentioned in lines 3, 4 and 5 above were in conformance with the rules of the Michigan Board of Land Surveyors or by a Decree of a Court of Law; established, re-established, monumented, re-monumented, recovered, found as expressed below:

NOTE: Not more than 4 corners, all in the same town and range, may be recorded on this certificate.

A. Description of original monument and accessories and/or subsequent restoration:

(F-9) 1/4 Corner Common to Sections 21 & 28 (T47N-R2E)

1974 N.D. Alix, L.S. 6254, on survey 74064-S, shows the Northwest corner of Section 28 and the West 1/16th corner between Sections 21 & 28 as being found. Also shows an iron being set 1064' East of the West 1/16th corner.

1978 Thomas M. Kelley, R.L.S. 24599, in a survey recorded in Liber 2, Page 55 & 56 of Surveys, indicates the Northwest corner of Section 28 and West 1/16th Corner between Sections 21 & 28 as being found.



B. Description of corner evidence found and/or method applied in restoring or reestablishing corner:

(F-9) This corner is being perpetuated as part of the Chippewa County Remonumentation Program.

Found no evidence of corner position. Found the three corners mentioned above. Re-established the East-West position of the 1/4 Corner by going East of the Northwest corner double the distance between the Northwest corner and West 1/16th Corner. Re-established the North-South position by putting it on the extension of a line between the West 1/16th Corner and the iron 1064' East of it.

C. Description of monument for corner and accessories established to perpetuate locating the position of the corner:
(F-9) Corner is a 3/4" x 24" iron with a 3" diameter aluminum "Chippewa County Remonumentation" cap. Corner falls 16' South of the centerline of 4 Mile Road (gravel).

Witnesses: 14" Spruce	S80°W	173.50'
7" Spruce	N52°E	7.08'
Witness Corner to the Meander Corner	S87°E	297.00'
12" Spruce	S52°W	101.32'
Power Pole	S78°W	103.28'

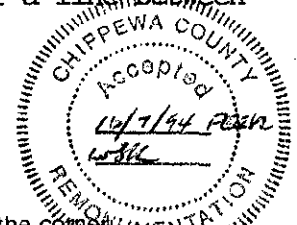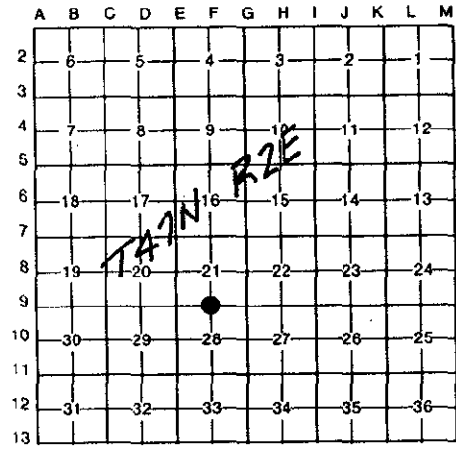

Signed by William L. Karr Date 2/1/94

Surveyor's Michigan License No. 27450

1697-00

NOTE: Bearings are compass bearings corrected for declination.
Distances are to a nail in side of witness objects unless noted.