

LAND CORNER RECORDATION CERTIFICATE
Filing Requirement of Act 74, Mich. P.A. 1970
Chippewa County Remonumentation Corner

For corners in

<u>Chippewa</u>	Located In:	Corner Code #
1. Public Land Survey	SAME <u>T 47N R 2E</u>	<u>H-1</u> ✓
	CORNER <u>T 48N R 2E</u>	<u>H-13</u>
	T _____ R _____	
	T _____ R _____	
2. Property Controlling in Section	S _____ T _____ R _____	
	S _____ T _____ R _____	
3. Miscellaneous Property in Sec.	S _____ T _____ R _____	
	S _____ T _____ R _____	

\$7.00 LAND CORNER
 \$2.00 MSSR
 21 JAN 1999 10:37:26 AM Receipt #13123
 RECEIVED FOR RECORD
 CHIPPEWA COUNTY - STATE OF MICHIGAN
 SHARON H. KENNEDY, REGISTER OF DEEDS

BOOK 10 PAGE 364
 Register of Deeds Stamp & File Number

4. Lot No. _____, Recorded Plat _____
 5. Private Claims _____

I, Larry R. Rogers, in a field survey on December 15, 1998, do hereby state that under requirements of P.A. 74, Michigan P.A. of 1970, the corner points mentioned in lines 1 and 2 above were in conformance with regulations and rules therefore as required in the current manual of survey instructions of the United States Department of the Interior, Bureau of Land Management or by a decree of a Court of Law and/or that the corner points mentioned in lines 3, 4 and 5 above were in conformance with the rules of the Michigan Board of Land Surveyors or by a Decree of a Court of Law; established, re-established, monumented, recovered, found as expressed below:

NOTE: Not more than 2 corners, all in the same town and range, may be recorded on this certificate.

A	B	C	D	E	F	G	H	I	J	K	L	M
1												
2	6	5	4	3	2	1						
3												
4	7	8	9	10	11	12						
5												
6	18	17	16	15	14	13						
7												
8	19	20	21	22	23	24						
9												
10	30	29	28	27	26	25						
11												
12	31	32	33	34	35	36						
13												

A. Description of original monument and accessories and/or subsequent restoration:

(H-1) North 1/4 corner of Section 3, Township 47 North, Range 2 East.

Corner was originally placed in 1842 by John Mullett. No reference to corner was found in County Surveyor notes. In 1994 a 1/2" re-rod with P.S. cap 22428 was found. In 1998 same corner was found and tied to Northeast and Northwest corners of Section 3.

B. Description of corner evidence found and/or method applied in restoring or reestablishing corner:

(H-1) North 1/4 corner of Section 3, Township 47 North, Range 2 East.

This corner is being re-established as part of the Chippewa County Remonumentation Program.

No evidence of original corner was found. Found 1/2" iron with P.S. 22428 as set by Ronald Blscher apparently mid-way and on line between Northwest and Northeast corners of Section 3. Distance to West is 2635.82 feet and distance to East is 2635.35 feet. Accepted corner position as found.


C. Description of monument for corner and accessories established to perpetuate locating the position of the corner:

(H-1) North 1/4 corner of Section 3, Township 47 North, Range 2 East.

Corner is a 1/2" re-rod with P.S. 22428 approximately 30 feet North of East-West two track road.

Witnesses:

12" double Maple	S38°E	4.63 feet
6" Maple	S75°W	6.20 feet
10" Maple	N70°W	14.22 feet
17" Hemlock	N75°E	30.32 feet
Metal Fence Post	North	2.0 feet

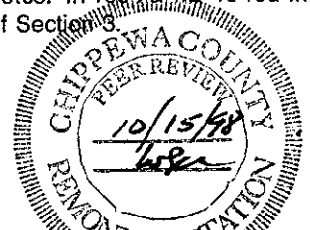

Signed by [Signature]

Date 30 DEC 1998

Surveyor's Michigan License No. 29251

NOTE: All bearings are compass bearings corrected for declination (6°W). All distances are to a nail and tag in the side of witness object unless otherwise noted.

FORM APPROVED BY MICHIGAN STATE BOARD OF PROFESSIONAL SURVEYORS, JAN. 28, 1971
 REVISED MAY 14, 1975
 REVISED JAN., 1983
 REVISED OCT., 1995