

SURVEY &  
REMONUMENTATION

DEC 07 1994

COMMISSION

Chippewa County Remonumentation Corner

LAND CORNER RECORDATION CERTIFICATE

Filing Requirement of Act 74, Mich. P.A. 1970, \$ 7.00

LAND CORNER  
RECORDING FEE

\$ 2.00 MSSR

18 OCT 94 1:04 P.M. RECEIPT# 700

RECEIVED FOR RECORD

CHIPPEWA COUNTY - STATE OF MICHIGAN  
SHARON H. KENNEDY, REGISTER OF DEEDS

For corners in  
Chippewa

(County)

Located In:

Corner Code #/


- |                                       |                          |            |
|---------------------------------------|--------------------------|------------|
| 1. Public Land Survey                 | T <u>47N</u> R <u>2E</u> | <u>I-3</u> |
|                                       | T _____ R _____          | _____      |
|                                       | T _____ R _____          | _____      |
|                                       | T _____ R _____          | _____      |
| 2. Property Controlling<br>in Section | S _____ T _____ R _____  | _____      |
|                                       | S _____ T _____ R _____  | _____      |
| 3. Miscellaneous<br>Property in Sec.  | S _____ T _____ R _____  | _____      |
|                                       | S _____ T _____ R _____  | _____      |

Register of Deeds Stamp & File Number

4. Lot No. \_\_\_\_\_, Recorded Plat \_\_\_\_\_  
5. Private Claims \_\_\_\_\_

I, William L. Karr, in a field survey on October 7, 19 93, do hereby certify that under requirements of P.A. 74, Michigan P.A. of 1970, the corner points mentioned in lines 1 and 2 above were in conformance with regulations and rules therefore as required in the current manual of survey instructions of the United States Department of the Interior, Bureau of Land Management or by a decree of a Court of Law and/or that the corner points mentioned in lines 3, 4 and 5 above were in conformance with the rules of the Michigan Board of Land Surveyors or by a Decree of a Court of Law; established, re-established, monumented, re-monumented, recovered, found as expressed below:

NOTE: Not more than 4 corners, all in the same town and range, may be recorded on this certificate.

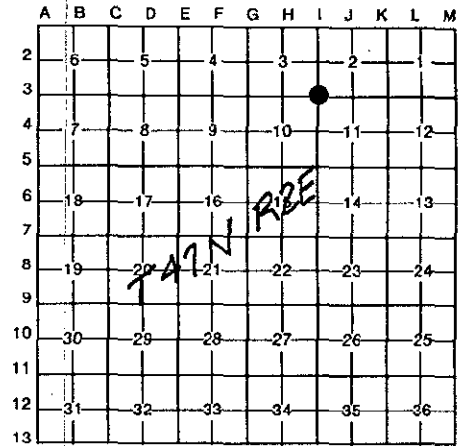


A. Description of original monument and accessories and/or subsequent restoration:  
(I-3) Corner Common to Sections 2, 11, 10 & 3, (T47N-R2E)

1845 J.H. Mullett, set post.  
5" Sugar S84°E 16 links  
6" Sugar N45°W 5 links

B. Description of corner evidence found and/or method applied in restoring or reestablishing corner:  
(I-3) This corner is being perpetuated as part of the Chippewa County Remonumentation Program.

Found a 4" diameter concrete monument 4" above ground with brass cap stamped "Chippewa County Corner". Corner worked well with others in the area. Accepted corner position as found.

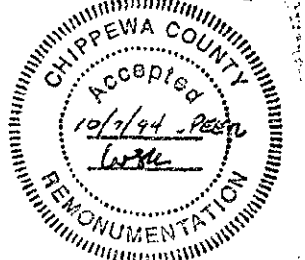

C. Description of monument for corner and accessories established to perpetuate locating the position of the corner:  
(I-3) Corner is a 4" diameter concrete monument 4" above ground with brass cap stamped "Chippewa County Corner".

Witnesses: 15" Triple Poplar N10°E 39.87'  
12" Poplar S25°E 18.60'  
10" Oak S87°W 18.09'  
5" Maple N37°W 11.30'



Signed by William L. Karr Date 2/1/94

Surveyor's Michigan License No. 27450

1798-00

NOTE: Bearings are compass bearings corrected for declination.  
Distances are to a nail in side of witness objects unless noted.