

DEC 07 1994

COMMISSION

Chippewa County Remonumentation Corner

LAND CORNER RECORDATION CERTIFICATE
Filing Requirement of Act 74, Mich. P.A. 1970

For corners in Chippewa (County)

- 1. Public Land Survey T 47N R 2E I-6
2. Property Controlling in Section S T R
3. Miscellaneous Property in Sec. S T R
4. Lot No. Recorded Plat
5. Private Claims

\$ 7.00 LAND CORNER
\$ 2.00 MSSR
18 OCT 94 1:04 P.M. RECEIPT# 700
RECEIVED FOR RECORD
CHIPPEWA COUNTY - STATE OF MICHIGAN
SHARON H. KENNEDY, REGISTER OF DEEDS

Register of Deeds Stamp & File Number

I, William L. Karr, in a field survey on September 28, 1993, do hereby certify that under requirements of P.A. 74, Michigan P.A. of 1970, the corner points mentioned in lines 1 and 2 above were in conformance with regulations and rules therefore as required in the current manual of survey instructions of the United States Department of the Interior, Bureau of Land Management or by a decree of a Court of Law and/or that the corner points mentioned in lines 3, 4 and 5 above were in conformance with the rules of the Michigan Board of Land Surveyors or by a Decree of a Court of Law; established, re-established, monumented, re-monumented, recovered, found as expressed below:

NOTE: Not more than 4 corners, all in the same town and range, may be recorded on this certificate.

A. Description of original monument and accessories and/or subsequent restoration: (I-6) 1/2 Corner Common to Sections 14 & 15 (T47N-R2E)

1845 J.H. Millett, set post.
8" Fir N34°W 23 links
10" Maple S27°E 17 links

B. Description of corner evidence found and/or method applied in restoring or reestablishing corner:



(I-6) This corner is being perpetuated as part of the Chippewa County Remonumentation Program.

Found a 1" square iron with several old wood hubs driven next to it. Corner falls on the extension of a very old fence far to the South and on the extension of an old logging road immediately to the South. Accepted corner position as found.

C. Description of monument for corner and accessories established to perpetuate locating the position of the corner:

(I-6) Corner is a 1" square iron on the extension of a logging road and a distance fence to the South.

Witnesses: 13" Spruce N50°E 25.40'
12" Balsam S30°E 15.25'
11" Poplar S11°W 29.71'
3" Maple N85°W 17.85'

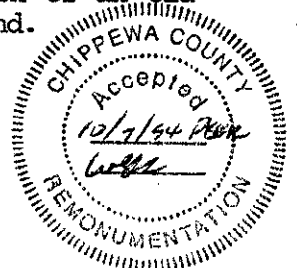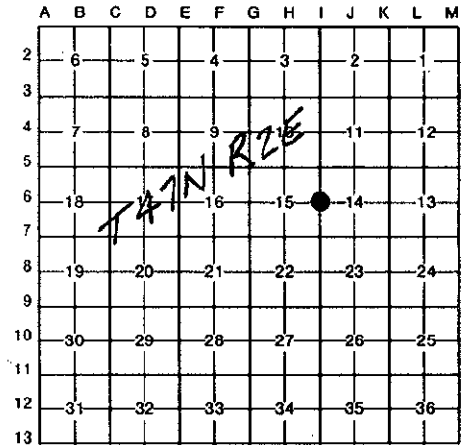

Signed by William L. Karr Date 2/1/94

Surveyor's Michigan License No. 27450

1772-00

NOTE: Bearings are compass bearings corrected for declination. Distances are to a nail in side of witness objects unless noted.