

SURVEY & REMONUMENTATION

FEB 23 2001

LAND CORNER RECORDATION CERTIFICATE
Filing Requirement of Act 74, Mich. P.A. 1970
 Chippewa County Remonumentation Corner

SECTION

For corners in

Chippewa County	Located in:	Corner Code #
1. Public Land Survey	T47N R2E	B-7
	T R	
	T R	
	T R	
2. Property Controlling in Section	S T R	
	S T R	
3. Miscellaneous Property in Sec.	S T R	
	S T R	
4. Lot No. , Recorded Plat		
5. Private Claims		

\$7.00 LAND CORNER

\$2.00 MSSR


9 FEB 2001 10:28:14 AM Receipt #1201
 RECEIVED FOR RECORD
 CHIPPEWA COUNTY - STATE OF MICHIGAN
 SHARON H. KENNEDY, REGISTER OF DEEDS

BOOK **11** PAGE **217**

Register of Deeds Stamp & File Number

I, Larry R. Rogers, P.S., in a field survey on December 01, 2000, do hereby state that under requirements of P.A. 74, Michigan P.A. of 1970, the corner points mentioned in lines 1 and 2 above were in conformance with regulations and rules therefore as required in the current manual of survey instructions of the United States Department of the Interior, Bureau of Land Management or by a decree of a Court of Law and for that the corner points mentioned in lines 3, 4 and 5 above were in conformance with the rules of the Michigan Board of Land Surveyors or by a Decree of a Court of Law; established, re-established, monumented, recovered, found as expressed below:

NOTE: Not more than 2 corners, all in the same town and range, may be recorded on this certificate.

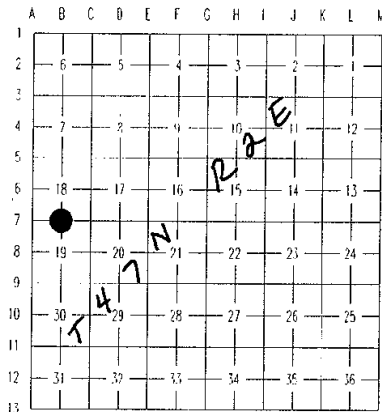

A. Description of original monument and accessories and/or subsequent restoration:

(B-7) 1/4 Corner common to Sections 18 and 19, Township 47 North, Range 2 East.

John Mullett set original 1/4 section post in 1845 and established a 10" Birch N54E 10 lks, and a 15" Birch S05W 28 lks as witnesses. A certificate of survey by N.D. Alix from 1976 indicates that he placed a 1/2" iron midway and on-line between the Southwest and Southeast corners of Section 18, but offers no ties to the 1/4 corner. W.L. Karr, P.S. 27450 found a 1/2" iron in 3 Mile Road. Accepted corner as found, and recorded L.C.R.C. in Liber 6 at Page 032 of the Chippewa County Records, dated 1983.



B. Description of corner evidence found and/or method applied in restoring or reestablishing corner:

(B-7) 1/4 Corner common to Sections 18 and 19, Township 47 North, Range 2 East.

This corner is being perpetuated as part of the Chippewa County Remonumentation Program

Found 1/2" iron pin 1.0 feet South of centerline of 3 Mile Road and 3 remaining witnesses as recorded previously. Accepted corner as found, established one new witness, and placed new nails and tags in two of the remaining witnesses. Distance to the Southwest corner of Section 18 measures 2564.74 feet (C.S. = 2569 feet). Distance to Southeast corner of Section 18 measures 2566.19 feet (C.S. = 2569 feet).



C. Description of monument for corner and accessories established to perpetuate locating the position of the corner:

(B-7) 1/4 Corner common to Sections 18 and 19, Township 47 North, Range 2 East.

Corner is a 1/2" iron 1.0 feet South of centerline of 3 Mile Road.

Witnesses:

Utility Pole (no #'s)	N71°W	134.99 feet	(new)
Utility Pole (no #'s)	N55°E	42.07 feet	(previous witness, new tag)
12" Cedar	S27°E	68.53 feet	(previous witness, new tag)
Utility Pole SU1127F17	S83°W	114.06 feet	(previous witness)

Bearings are magnetic compass bearings. All distances are to a nail and tag in the side of the witness object unless otherwise noted.

Signed by [Signature]
 Larry R. Rogers, P.S.
 Surveyor's Michigan License No. 29251

Date 29 DEC 2000