

**SURVEY &
REMONUMENTATION**

DEC 09 1993

Chippewa County Remonumentation Corner

LAND CORNER RECORDATION CERTIFICATE

Filing Requirement of Act 74, Mich. P.A. 1970

RECEIVED FOR RECORD
CHIPPEWA COUNTY
STATE OF MICHIGAN

93 NOV 31 AM 10:09

J. Roger Malachuk
REGISTER OF DEEDS

Register of Deeds Stamp & File Number

For corners in **COMMISSION**

Chippewa
(County)

Located In: Corner Code #/

1. Public Land Survey	T 46N R 2W	H-1 / Same
	T 47N R 2W	H-13 / Corner
	T _____ R _____	_____ / _____
	T _____ R _____	_____ / _____
2. Property Controlling in Section	S _____ T _____ R _____	_____ / _____
	S _____ T _____ R _____	_____ / _____
3. Miscellaneous Property in Sec.	S _____ T _____ R _____	_____ / _____
	S _____ T _____ R _____	_____ / _____

4. Lot No. _____, Recorded Plat _____
5. Private Claims _____

	A	B	C	D	E	F	G	H	I	J	K	L	M
2	6	5	4	3	2	1							
3													
4	7	8	9	10	11	12							
5													
6	18	17	16	15	14	13							
7													
8	19	20	21	22	23	24							
9													
10	30	29	28	27	26	25							
11													
12	31	32	33	34	35	36							
13													

I, William L. Karr, in a field survey on May 25, 19 93, do hereby certify that under requirements of P.A. 74, Michigan P.A. of 1970, the corner points mentioned in lines 1 and 2 above were in conformance with regulations and rules therefore as required in the current manual of survey instructions of the United States Department of the Interior, Bureau of Land Management or by a decree of a Court of Law and/or that the corner points mentioned in lines 3, 4 and 5 above were in conformance with the rules of the Michigan Board of Land Surveyors or by a Decree of a Court of Law; established, re-established, monumented, re-monumented, recovered, found as expressed below:

NOTE: Not more than 4 corners, all in the same town and range, may be recorded on this certificate.


A. Description of original monument and accessories and/or subsequent restoration:

(H-1) 1/4 Corner Sections 34/3

1947 Supervisor's Plat Number 1 of Bay Mills and Superior Recorded Liber 6, Page 1 of Plats shows a concrete monument.

1976 N.D. Alix, L.S. 6254, Recorded in Liber 1, Page 217 of Corner Records. Found a 4" square concrete monument with 1/2" iron in center.

12" White Birch	S72°W	35.28'
14" White Birch	S36°W	32.26'
6" Red Maple	N75°E	13.67'

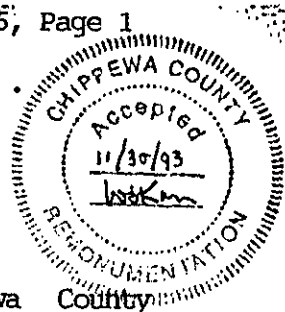

B. Description of corner evidence found and/or method applied in restoring or reestablishing corner:

(H-1) This corner is being perpetuated as part of the Chippewa County Remonumentation Program.

Found record corner. Corner of concrete has been broken off. Found two record ties (trees), but nothing in the sides of them. Set nails in the sides and added additional ties. Accepted the corner position as found.

C. Description of monument for corner and accessories established to perpetuate locating the position of the corner:

(H-1) Corner is a 4" square concrete monument with top broken off and iron in center. It falls 16.5' East of centerline of Edmonds Road at curve and falls on extension of centerline of Edmonds Road to the South.

Witnesses: 12" Maple (Fd blaze)	N09°E	26.27'
8" Red Maple (Fd blaze)	N72°E	13.60'
4" Maple	S28°W	60.11'
12" White Birch (Fd blaze)	S70°W	35.42'
2" high metal fence post	South	0.80'



Signed by William L. Karr Date 11/12/93

Surveyor's Michigan License No. 27450

NOTE: Bearings are compass bearings corrected for declination. Distances are to a nail in side of witness objects unless noted.