

LAND CORNER RECORDATION CERTIFICATE
Filing Requirement of Act 74, Mich. P.A. 1970

For corners in

Chippewa

(County)

Located In:

Corner Code #/

1. Public Land Survey

T 46N R 2W J-1 Same
T 47N R 2W J-13 Corner

2. Property Controlling in Section

S T R
S T R

3. Miscellaneous Property in Sec.

S T R
S T R

4. Lot No. _____, Recorded Plat _____

5. Private Claims _____

RECEIVED FOR RECORD
CHIPPEWA COUNTY
STATE OF MICHIGAN

94 JUL 22 AM 11:18

J. Roger Malott

REGISTER OF DEEDS

Register of Deeds Stamp & File Number

I, William L. Karr, in a field survey on NOVEMBER 3, 19 93, do hereby certify that under requirements of P.A. 74, Michigan P.A. of 1970, the corner points mentioned in lines 1 and 2 above were in conformance with regulations and rules therefore as required in the current manual of survey instructions of the United States Department of the Interior, Bureau of Land Management or by a decree of a Court of Law and/or that the corner points mentioned in lines 3, 4 and 5 above were in conformance with the rules of the Michigan Board of Land Surveyors or by a Decree of a Court of Law; established, re-established, monumented, re-monumented, recovered, found as expressed below:

NOTE: Not more than 4 corners, all in the same town and range, may be recorded on this certificate.

A. Description of original monument and accessories and/or subsequent restoration:

(J-1) North 1/4 Corner Section 2


Subsequent restoration: Corner is recorded in Liber 5, Page 215 of Chippewa County Records. Corner is a railroad spike.

1987: W.L. Karr reset corner (Liber 6, Page 366)

Southwest corner of Garage N39°E 47.66'
Power Pole (E-160) S51°E 68.49'
Power Pole (E-161) S60°W 111.25'
10" Spruce N46°W 74.62'

B. Description of corner evidence found and/or method applied in restoring or reestablishing corner:

(J-1) Found corner and all accessories as recorded in Liber 5, Page 215 of the Chippewa County Records. Accepted corner position as found.

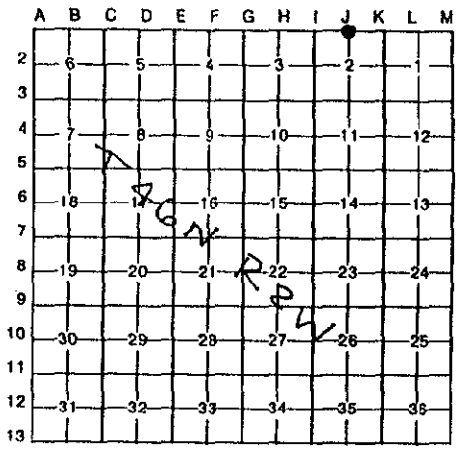

SURVEY &
REMONUMENTATION

JUL 26 1994

COMMISSION

C. Description of monument for corner and accessories established to perpetuate locating the position of the corner:
(J-1) Corner is a 1/2" x 18" iron with cap #27450 in monument box, approximately 1.2' North of the centerline of 6 Mile Road.

Witnesses: Southwest corner of Garage N39°E 47.66'
Power Pole (E-160) S51°E 68.49'
Power Pole (E-161) S60°W 111.25'
10" Spruce N46°W 74.62'



Signed by William L. Karr

Date 7/21/94

Surveyor's Michigan License No. 27450

NOTE: Bearings are compass bearings corrected for declination.
Distances are to a nail in side of witness objects unless noted.