

CHIPPEWA COUNTY REMONUMENTATION CORNER

LAND CORNER RECORDATION CERTIFICATE

Filing Requirement of Act 74, Mich. P.A. 1970

For corners in

Chippewa

(County)

Located In:

Corner Code #

- 1. Public Land Survey T 47N R 7W B-5  
T \_\_\_\_\_ R \_\_\_\_\_  
T \_\_\_\_\_ R \_\_\_\_\_  
T \_\_\_\_\_ R \_\_\_\_\_
- 2. Property Controlling S \_\_\_\_\_ T \_\_\_\_\_ R \_\_\_\_\_  
in Section S \_\_\_\_\_ T \_\_\_\_\_ R \_\_\_\_\_
- 3. Miscellaneous S \_\_\_\_\_ T \_\_\_\_\_ R \_\_\_\_\_  
Property in Sec. S \_\_\_\_\_ T \_\_\_\_\_ R \_\_\_\_\_

\$ 7.00 LAND CORNER

\$ 2.00 MSSR

24 OCT 94 2:24 P.M.

RECEIPT# 811

RECEIVED FOR RECORD

CHIPPEWA COUNTY - STATE OF MICHIGAN


SHARON H. KENNEDY, REGISTER OF DEEDS

Register of Deeds Stamp & File Number

4. Lot No. \_\_\_\_\_, Recorded Plat \_\_\_\_\_

5. Private Claims \_\_\_\_\_

I, Larry R. Rogers, in a field survey on July 14, 19 93, do hereby certify that under requirements of P.A. 74, Michigan P.A. of 1970, the corner points mentioned in lines 1 and 2 above were in conformance with regulations and rules therefore as required in the current manual of survey instructions of the United States Department of the Interior, Bureau of Land Management or by a decree of a Court of Law and/or that the corner points mentioned in lines 3, 4 and 5 above were in conformance with the rules of the Michigan Board of Land Surveyors or by a Decree of a Court of Law; established, re-established, monumented, re-monumented, recovered, found as expressed below:

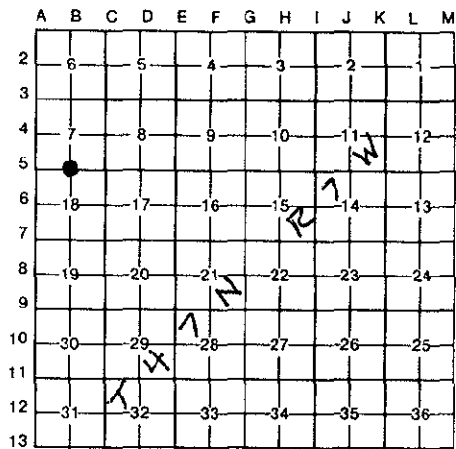

NOTE: Not more than 4 corners, all in the same town and range, may be recorded on this certificate.

A. Description of original monument and accessories and/or subsequent restoration:

(B-5) 1/4 Corner common to Sections 7 & 18, T47N-R7W

1958 Harold Bruning, Escanaba Paper Company, recorded in Liber 2, Page 175 of Corner Records. Found original evidence and replaced corner with a 1 1/2" pipe and brass cap. Added two witnesses.

8" Beech N43°E 71 links 12" Beech N65°W 66.5 links

1984 Robert E. Schmeling, L.S. #8317, found recorded monument and original GLO bearing trees and remains or record bearing trees. Added three new bearing trees.

7" Yellow Birch S38°W 28.9' (to PK nail)


6" Yellow Birch S16°E 25.1' (to PK nail)

8" Sugar Maple N34°E 22.8' (to PK nail)

B. Description of corner evidence found and/or method applied in restoring or reestablishing corner:

This corner is being perpetuated as part of the Chippewa County Remonumentation Program.

Found 1 1/2" O.D. pipe 12" above ground with 4" diameter stamped brass cap. Found original GLO Maple bearing tree (fallen). Found four recorded bearing trees. Blazes and PK nails grown over. Added nails and tags to the sides of existing bearing trees. Accepted corner position as found.

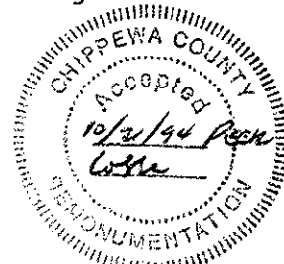

C. Description of monument for corner and accessories established to perpetuate locating the position of the corner: Corner is a 1 1/2" O.D. pipe 12" above ground with a 4" diameter stamped brass cap. Corner falls 77' North of the centerline of an East-West road (sand).

Witnesses:

- 20" Beech N67°W 44.00' (existing)
- 8" Maple N29°E 22.87' (existing)
- Original GLO Bearing Tree (Fallen) S38°E 39.70' (existing)
- 8" Yellow Birch S19°E 24.96' (existing)
- 12" Yellow Birch S33°W 29.13' (existing)
- 4" Wood Post & Locator Tag West 0.50' (existing)



Signed by \_\_\_\_\_ Date 10 OCT 1994 1609-00

Surveyor's Michigan License No. 29251

NOTE: Bearings are compass bearings corrected for declination. Distances are to a nail in side of witness objects unless noted.