

MAR 18 1999

LAND CORNER RECORDATION CERTIFICATE
 Filing Requirement of Act 74, Mich. P.A. 1970
 Chippewa County Remonumentation Corner

For corners in SECTION

Chippewa Located In: Corner Code #

1. Public Land Survey SAME CORNER { T 48N R 1E M-12 ✓
 T 48N R 2E A-12
 T ___ R ___
 T ___ R ___

2. Property Controlling in Section S ___ T ___ R ___
 S ___ T ___ R ___

3. Miscellaneous Property in Sec. S ___ T ___ R ___
 S ___ T ___ R ___

47.00 LAND CORNER
 42.00 MSSR
 21 JAN 1999 11:08:36 AM Receipt #13123
 RECEIVED FOR RECORD
 CHIPPEWA COUNTY - STATE OF MICHIGAN
 SHARON H. KENNEDY, REGISTER OF DEEDS

BOOK 10 PAGE 374

Register of Deeds Stamp & File Number

4. Lot No. _____, Recorded Plat _____
 5. Private Claims _____

I, Larry R. Rogers, in a field survey on December 9, 1998, do hereby state that under requirements of P.A. 74, Michigan P.A. of 1970, the corner points mentioned in lines 1 and 2 above were in conformance with regulations and rules therefore as required in the current manual of survey instructions of the United States Department of the Interior, Bureau of Land Management or by a decree of a Court of Law and/or that the corner points mentioned in lines 3, 4 and 5 above were in conformance with the rules of the Michigan Board of Land Surveyors or by a Decree of a Court of Law; established, re-established, monumented, recovered, found as expressed below:

NOTE: Not more than 2 corners, all in the same town and range, may be recorded on this certificate.

1	A	B	C	D	E	F	G	H	I	J	K	L	M
2		6		5		4		3			2		1
3													
4		7		8		9		10		11			12
5													
6		16		17		18		15		14			13
7													
8		19		20		21		22		23			24
9													
10		30		29		28		27		26			25
11													
12		31		32		33		34		35			36
13													

A. Description of original monument and accessories and/or subsequent restoration:
 (M-12) East 1/4 Corner of Section 36, Township 48 North, Range 1 East.

The original corner was placed in 1845 by John Mullett. Found no record of corner in County Surveyor notes. In 1970, N.D. Alix set a 1/2" iron with cap number 6254. In 1984, William L. Karr, P.S. 27450 found Alix 1/2" iron at a fence intersection. In 1991, Karr replaced 1/2" iron with 1/2" x 48" rerod with stamped aluminum cap, added two new witnesses and filed a L.C.R.C. in Liber 9, Page 128 of the Chippewa County Corner Records.

B. Description of corner evidence found and/or method applied in restoring or reestablishing corner:
 (M-12) East 1/4 Corner of Section 36, Township 48 North, Range 1 East.


This corner is being perpetuated as part of the Chippewa County Remonumentation Program. Found 1/2" iron pin with 2" stamped aluminum cap as recorded by Karr. Fences in area of corner are now gone. Accepted the position as found.

C. Description of monument for corner and accessories established to perpetuate locating the position of the corner:

(M-12) East 1/4 Corner of Section 36, Township 48 North, Range 1 East.
 Corner is a 1/2" iron pin with 2" stamped aluminum cap in swampy area.

Witnesses:

4" Balsam Fir	N24°E	21.74 feet
18" Spruce	N56°W	32.45 feet
10" Spruce	S16°W	69.83 feet
12" Spruce	S74°E	51.57 feet
Metal Fence Post	North	2.0 feet

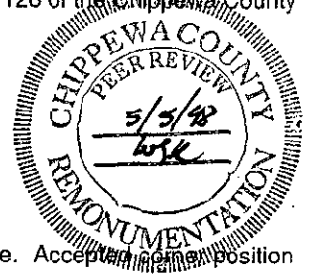

Signed by [signature] Date 30 DEC 1998

Surveyor's Michigan License No. 29251

NOTE: All bearings are compass bearings corrected for declination (6°W). All distances are to a nail and tag in the side of witness object unless otherwise noted.