

1999

LAND CORNER RECORDATION CERTIFICATE
Filing Requirement of Act 74, Mich. P.A. 1970
Chippewa County Remonumentation Corner

For corners in SECTION

Chippewa Located In: Corner Code #

1. Public Land Survey SAME { T 47N R 2E B-1
CORNER { T 48N R 2E B-13 ✓
T ___ R ___
T ___ R ___
S ___ T ___ R ___
S ___ T ___ R ___
S ___ T ___ R ___
S ___ T ___ R ___

2. Property Controlling in Section

3. Miscellaneous Property in Sec.

4. Lot No. _____, Recorded Plat _____

5. Private Claims _____


\$7.00 LAND CORNER
\$2.00 MSSR
21 JAN 1999 11:11:10 AM Receipt #13123
RECEIVED FOR RECORD
CHIPPewa COUNTY - STATE OF MICHIGAN
SHARON H. KENNEDY, REGISTER OF DEEDS

BOOK 10 PAGE 378

Register of Deeds Stamp & File Number

I, Larry R. Rogers, in a field survey on November 09, 1998, do hereby state that under requirements of P.A. 74, Michigan P.A. of 1970, the corner points mentioned in lines 1 and 2 above were in conformance with regulations and rules therefore as required in the current manual of survey instructions of the United States Department of the Interior, Bureau of Land Management or by a decree of a Court of Law and/or that the corner points mentioned in lines 3, 4 and 5 above were in conformance with the rules of the Michigan Board of Land Surveyors or by a Decree of a Court of Law; established, re-established, monumented, recovered, found as expressed below:

NOTE: Not more than 2 corners, all in the same town and range, may be recorded on this certificate.

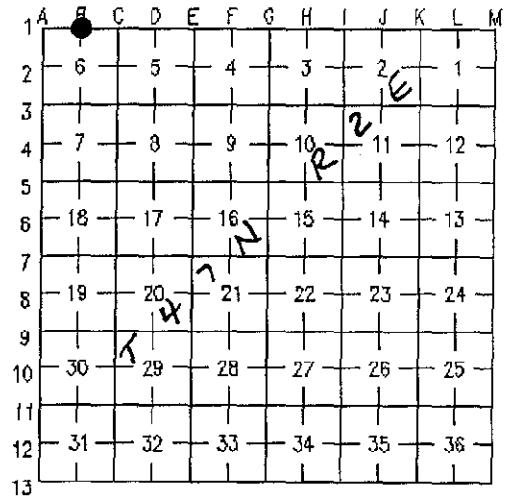

A. Description of original monument and accessories and/or subsequent restoration:

(B-1) North 1/4 corner of Section 6, Township 47 North, Range 2 East.


The original corner was placed in 1842 by John Mullett. 1915 County Survey notes give distance of 2587.5 feet East and West to Section corner. In 1991, William L. Karr, P.S. 27450 re-established corner position on line between section corners to East and West and on the extension of a fence to the South and recorded a LCRC in Liber 9, Page 134 of Chippewa County Corner Records. Distance East to Northeast corner of Section 6 is 2587.00 feet.

B. Description of corner evidence found and/or method applied in restoring or reestablishing corner:

(B-1) North 1/4 corner of Section 6, Township 47 North, Range 2 East.

This corner is being perpetuated as part of the Chippewa County Remonumentation Program.

Found "Karr" 1/2" iron pin 4" below grade of East-West gravel road and on the extension of a fence line to South. Recovered one "Karr" witness. Because few witnesses are available, two capped 3/4" iron pipes were set 10" below grade in Northwest and Southwest quadrants. Accepted corner position as found.

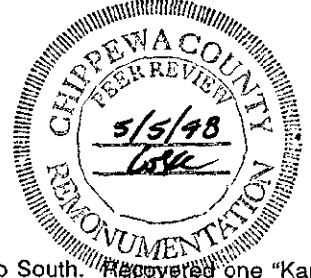

C. Description of monument for corner and accessories established to perpetuate locating the position of the corner:

(B-1) North 1/4 corner of Section 6, Township 47 North, Range 2 East.

Corner is a 1/2" iron pin 4" below grade, 2 feet South of centerline of East-West gravel road and on the extension of a fenceline to South.

Witnesses:

Utility Pole SUI/25/40	N16°E	31.16 feet
Corner Fence Post	S03°W	36.92 feet
3/4" capped iron pipe	S60°W	36.04 feet
3/4" capped iron pipe	N50°W	42.79 feet

Signed by _____ Date 30 DEC 1998



Surveyor's Michigan License No. 29251

NOTE: All bearings are magnetic compass bearings. All distances are to a nail and tag in the side of witness object unless otherwise noted.