

1999

LAND CORNER RECORDATION CERTIFICATE
Filing Requirement of Act 74, Mich. P.A. 1970
Chippewa County Remonumentation Corner

\$7.00 LAND CORNER
\$2.00 MSSR
21 JAN 1999 11:11:46 AM Receipt #13123
RECEIVED FOR RECORD
CHIPPWEA COUNTY - STATE OF MICHIGAN
SHARON H. KENNEDY, REGISTER OF DEEDS

SECTION

For comers in

Chippewa Located In: Corner Code #
1. Public Land Survey SAME CORNER { T 47N R 2E C-1
T 48N R 2E C-13
T R
T R
2. Property Controlling S T R
S T R
3. Miscellaneous S T R
Property in Sec. S T R
4. Lot No. , Recorded Plat
5. Private Claims


BOOK 10 PAGE 379
Register of Deeds Stamp & File Number


I, Larry R. Rogers, in a field survey on November 11, 1998, do hereby state that under requirements of P.A. 74, Michigan P.A. of 1970, the corner points mentioned in lines 1 and 2 above were in conformance with regulations and rules therefore as required in the current manual of survey instructions of the United States Department of the Interior, Bureau of Land Management or by a decree of a Court of Law and/or that the corner points mentioned in lines 3, 4 and 5 above were in conformance with the rules of the Michigan Board of Land Surveyors or by a Decree of a Court of Law; established, re-established, monumented, recovered, found as expressed below:

NOTE: Not more than 2 corners, all in the same town and range, may be recorded on this certificate.

A. Description of original monument and accessories and/or subsequent restoration:
(C-1) Northeast corner of Section 6, Township 47 North, Range 2 East.
The original corner was placed in 1852 by John Mullett. Subsequent County Surveyor notes indicate a cedar post and cement post at corner. In 1991, William L. Karr, P.S. 27450 found a wood post and 1" iron pin in road intersection. Did not find cement post. Karr accepted the 1" iron pin and recorded a L.C.R.C. in Liber 9, Page 133 of the Chippewa County Records.

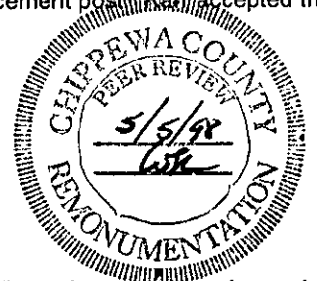

B. Description of corner evidence found and/or method applied in restoring or reestablishing corner:
(C-1) Northeast corner of Section 6, Township 47 North, Range 2 East.
This corner is being perpetuated as part of the Chippewa County Remonumentation Program. Found 1" iron pin used by Karr. Corner is 4" below grade, on the centerline of Brassar Road (N-S, gravel), on the centerline of gravel road to West and 15 feet South of centerline of gravel road to East. Found three "Karr" witnesses intact. Accepted corner position as found.

C. Description of monument for corner and accessories established to perpetuate locating the position of the corner:
(C-1) Northeast corner of Section 6, Township 47 North, Range 2 East.
Corner is a 1" iron pin next to old wood post 4" below grade of gravel road intersection.



Witnesses:

Table with 3 columns: Witness, Bearing, Distance.
Utility Pole N51°W 46.43 feet
8" Aspen N42°E 78.18 feet
Old Well (hand pump) S30°E 187.15 feet
10" Spruce S40°W 58.32 feet

Signed by [Signature] Date 30 DEC 1998

Surveyor's Michigan License No. 29251

NOTE: All bearings are compass bearings corrected for declination (6°W). All distances are to a nail and tag in the side of witness object unless otherwise noted.