

Book 10 1999

LAND CORNER RECORDATION CERTIFICATE
Filing Requirement of Act 74, Mich. P.A. 1970
Chippewa County Remonumentation Corner

SECTION

For corners in

<u>Chippewa</u>	Located In:	Corner Code #
1. Public Land Survey	SAME CORNER { T 47N R 2E T 48N R 2E T ___ R ___ T ___ R ___	G-1 G-13 ✓
2. Property Controlling in Section	S ___ T ___ R ___ S ___ T ___ R ___	
3. Miscellaneous Property in Sec.	S ___ T ___ R ___ S ___ T ___ R ___	
4. Lot No. _____, Recorded Plat _____		
5. Private Claims _____		

\$7.00 LAND CORNER
\$2.00 MSSR
21 JAN 1999 10:36:51 AM Receipt #13123
RECEIVED FOR RECORD
CHIPPewa COUNTY - STATE OF MICHIGAN
SHARON H. KENNEDY, REGISTER OF DEEDS


BOOK 10 PAGE 363
Register of Deeds Stamp & File Number

1	A	B	C	D	E	F	G	H	I	J	K	L	M
2		6		5		4		3		2		1	
3										2			
4		7		8		9		10		11		12	
5													
6		18		17		16		15		14		13	
7													
8		19		20		21		22		23		24	
9													
10		30		29		28		27		26		25	
11													
12		31		32		33		34		35		36	
13													

I, Larry R. Rogers, in a field survey on November 12, 1998, do hereby state that under requirements of P.A. 74, Michigan P.A. of 1970, the corner points mentioned in lines 1 and 2 above were in conformance with regulations and rules therefore as required in the current manual of survey instructions of the United States Department of the Interior, Bureau of Land Management or by a decree of a Court of Law and/or that the corner points mentioned in lines 3, 4 and 5 above were in conformance with the rules of the Michigan Board of Land Surveyors or by a Decree of a Court of Law; established, re-established, monumented, recovered, found as expressed below:

NOTE: Not more than 2 corners, all in the same town and range, may be recorded on this certificate.

A. Description of original monument and accessories and/or subsequent restoration:
(G-1) Northeast corner of Section 4, Township 47 North, Range 2 East.
Original corner was placed in 1842 by John Mullett. In 1920, County Surveyor Brown measured 5280 feet East from Northwest corner of Section 4 and set a post. Subsequent County Surveyor notes call for a cedar post and 1" x 30" bolt with three maple witnesses.

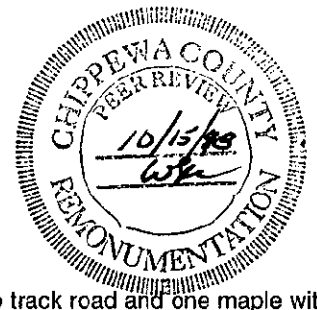

B. Description of corner evidence found and/or method applied in restoring or reestablishing corner:
(G-1) Northeast corner of Section 4, Township 47 North, Range 2 East.
This corner is being perpetuated as part of the Chippewa County Remonumentation Program. Found no evidence of original corner. Found 1" iron with mushroomed top in centerline of East-West two track road and one maple witness from County Surveyor notes. Corner is only 5249.4 feet East of Northwest corner of Section 4 (County Surveyor 5280) but corner and maple witness match County Surveyor description. Accepted corner position as found and established new witnesses.

C. Description of monument for corner and accessories established to perpetuate locating the position of the corner:
(G-1) Northeast corner of Section 4, Township 47 North, Range 2 East.
Corner is a 1" iron with mushroomed top in centerline of East-West two track road.



Witnesses:

- 10" Maple N43°E 17.25 feet
- 12" Maple S67°W 30.45 feet
- 8" Maple N50°W 29.48 feet
- 12" Maple S41°E 43.83 feet

Signed by [Signature] Date 30 DEC 1998

Surveyor's Michigan License No. 29251

NOTE: All bearings are compass bearings corrected for declination (6°W). All distances are to a nail and tag in the side of witness object unless otherwise noted.