


MAP SHEET


TOWN 49 N RANGE 6 W

| | |
|---------------|----------|
| DATE | FILE NO. |
| DIVISION | DISTRICT |
| MAPPED BY: | |
| PHOTO NUMBERS | |

| | | | |
|---------------------------|----------|-----------------|--|
| COUNTY Chippewa | TOWNSHIP | NUMBER OF ACRES | |
| OWNER OF LAND | | | |
| PURPOSE OF MAP | | | |

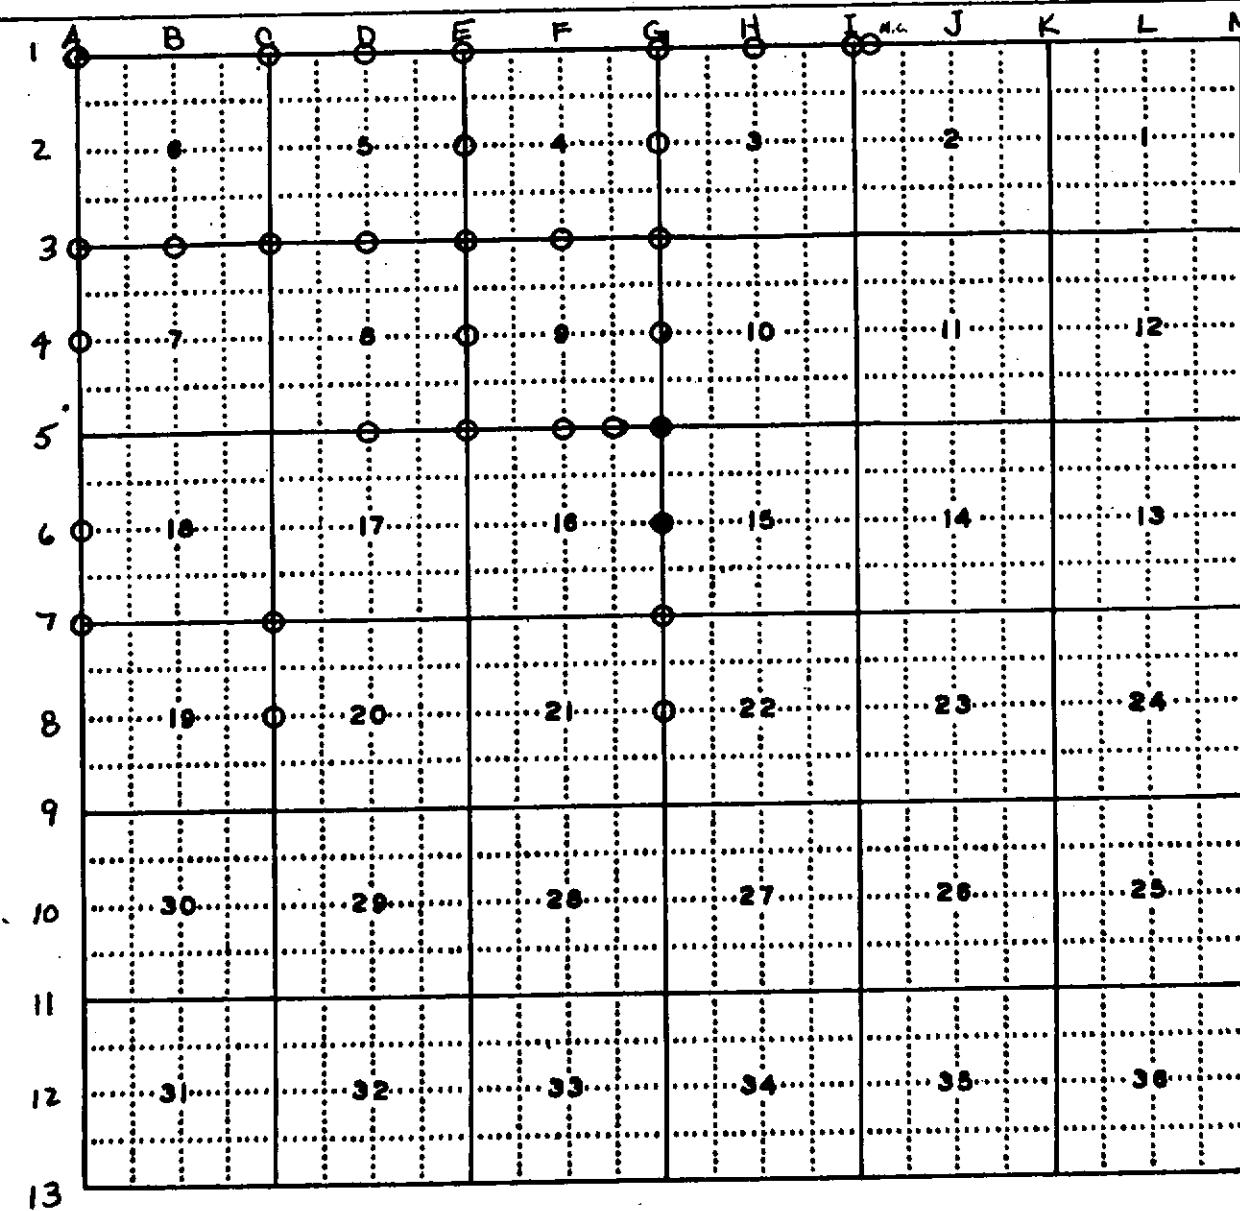

REMARKS

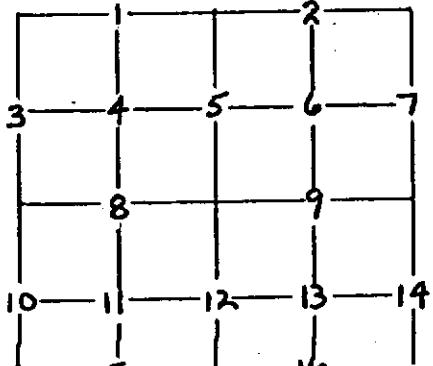

• - denotes 2 records