

STATE OF MICHIGAN
DEPARTMENT
OF
NATURAL RESOURCES

LAND CORNER RECORD


Chippewa COUNTY
T 49N R 6W

DESCRIPTION OF CORNER Closing corner bet. Secs. 3-4, on the Township Line

CORNER MONUMENT 1" Pipe with 4" Aluminum Cap

DATE MONUMENT PLACED AND WITNESSED 7-14-71

WITNESSES TO CORNER..... 9" Jack Pine (C.C. NBT) N44° W 10.6'

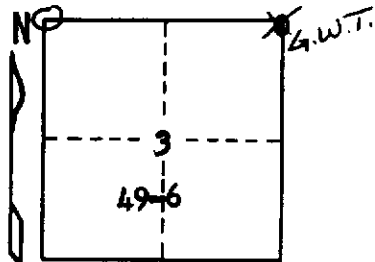

9" Jack Pine (C.C. NBT) N30°E 16.1'

AND

CIRCLE CORNER REGISTERED

DESCRIPTION IN DETAIL AS TO HOW CORNER WAS LOCATED AND IDENTIFIED OR RESTORED.

This corner re-established by Single Proportionate Measure, along the Township Line, between $\frac{1}{4}$ Cor. (South side Sec. 33-50-6), $\frac{1}{2}$ mile West and a closing corner, 1 mile East.

Found no evidence of original corner.

Note: This closing corner lies 365.4' West of Sec. Cor. 33-34-T50N R6W.

SURVEYOR'S SEAL

Billy D. Buckler

SIGNED

Billy D. Buckler

DATE

9-28-71

DISTRIBUTION:

REGISTERED LAND SURVEYOR

County Courthouse
Area Forester (Regions I & II)
District or Region Surveyor
Forestry Div., Lansing

R 4047
Rev. 10/68