

LAND CORNER RECORDATION CERTIFICATE

FILING REQUIREMENT OF ACT 74, MICH. P.A.1970

CHIPPEWA COUNTY 2 Corners.

FOR CORNERS OF--:	LOCATED IN--:	CORNER CODE NUMBER
1. PUBLIC LAND SURVEY _____	T. <u>49</u> ^{N.} / _{S.} , R. <u>6</u> ^{E.} / _{W.}	<u>G-6; G-5;</u>
2. PROPERTY CONTROLLING IN SECTION _____	T. _____, S. _____, R. _____, E. _____, W. _____	_____
3. MISCELLANEOUS PROPERTY IN SECTION _____	T. _____, S. _____, R. _____, E. _____, W. _____	_____
4. LOT NO. _____, RECORDED PLAT _____		
5. PRIVATE CLAIMS _____		


REGISTER OF DEEDS STAMP AND FILING NUMBER

I, Billy D. Buckler, RLS., do hereby certify that under requirements of P.A. 74, Michigan P.A. of 1970, the corner points mentioned in lines 1 and 2 above were, in a field survey on 11/13/75, 19____, established, re-established, monumented, re-monumented, recovered or restored as expressed below and in conformance with regulations and rules therefore as required in the current manual of survey instructions of the United States Department of the Interior, Bureau of Land Management or by a decree of a court of law. Furthermore, that the corner points mentioned in lines 3, 4 and 5 above were, in a field survey on _____, 19____, found, recovered, restored, established or re-established as expressed below and in conformance with the rules of the Michigan State Board of Registration for Land Surveyors or, by a Decree of a Court of law:

- A. Description of original monument and accessories and/or subsequent restoration:
Corners set by Wells Burt, D.S. in 1849.
G-6; Quarter Corner bet. Secs 15-16. Bearings were:
 Y.Pine 10", S21e, 35 Lks. and W.Pine 12", N35W, 27 Lks.
G-5; Sec. Cor. 9-10-15-16. Bearings were:
 Y.Pine 12", N64E, 45 Lks. and W.Pine 18", S85E, 50 Lks.
- B. Description of corner evidence found and/or method applied in restoring or re-establishing corner:
G-6 Corner replaced from two original witnesses. Found remains of notch and scribe marks on both.
G-5 Corner re-established by proportionate measure bet. corner 1/2 mile South and 2 miles North. No evidence of original corner.
- C. Description of monument for corner and accessories established to perpetuate locating the position of the corner:
Placed 1" pipe with 4" Aluminium cap at both corners.
G-6 New Bearings: 6" R. Pine, N53°W, 18.1' and 8" R. Pine, S48°W, 35.1'.
G-5 New Bearings: 16" W. Pine, N32°W, 80.9' and 16" R. Pine, S43°W, 103.1'.

SIGNED BY *Billy D. Buckler* DATE 2-15-77
 Billy D. Buckler

SURVEYOR'S MICHIGAN REGISTRATION NO. 8887

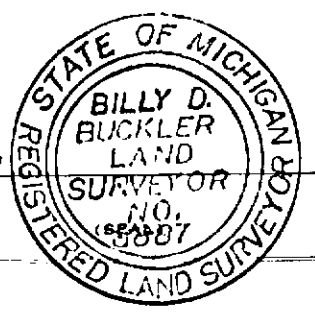

FOR STATE AND UNITED STATES AGENCIES:

SIGNED BY _____ DATE _____
CHIEF OF SURVEY PARTY

APPROVED AND SIGNED BY _____ DATE _____
MICHIGAN REGISTERED LAND SURVEYOR

SURVEYOR'S MICHIGAN REGISTRATION NO. _____