

LAND CORNER RECORDATION CERTIFICATE
Filing Requirement of Act 74, Mich. P.A. 1970 as Amended

For corners in

| | | |
|---------------------------------------|------------------|----------------|
| <u>Chippewa</u> (County) | Located In: | Corner Code # |
| 1. Public Land Survey | T <u>49NR 6W</u> | <u>E4</u> |
| | T <u>49NR 6W</u> | <u>F5</u> |
| | T <u> R</u> | _____ |
| S <u> </u> | T <u> R</u> | _____ |
| 2. Property Controlling in Section | S <u> </u> | T <u> R</u> |
| | S <u> </u> | T <u> R</u> |
| 3. Miscellaneous Property in Sec. | S <u> </u> | T <u> R</u> |
| | S <u> </u> | T <u> R</u> |

Register of Deeds Stamp & File Number

4. Lot No. _____, Recorded Plat _____
 5. Private Claims

F5 Apr 24 2006
 E4 Apr 06 2006

| | | | | | | | | | | | | |
|----|----|---|----|---|----|---|----|---|----|---|----|---|
| A | B | C | D | E | F | G | H | I | J | K | L | M |
| 1 | | | | | | | | | | | | |
| 2 | 6 | | 5 | | 4 | | 3 | | 2 | | 1 | |
| 3 | | | | | | | | | | | | |
| 4 | 7 | | 8 | ● | 9 | | 10 | | 11 | | 12 | |
| 5 | | | | | ● | | | | | | | |
| 6 | 18 | | 17 | | 16 | | 15 | | 14 | | 13 | |
| 7 | | | | | | | | | | | | |
| 8 | 19 | | 20 | | 21 | | 22 | | 23 | | 24 | |
| 9 | | | | | | | | | | | | |
| 10 | 30 | | 29 | | 28 | | 27 | | 26 | | 25 | |
| 11 | | | | | | | | | | | | |
| 12 | 31 | | 32 | | 33 | | 34 | | 35 | | 36 | |
| 13 | | | | | | | | | | | | |

I, Stephan J. Szyszkoski, in a field survey on _____, 20____ do hereby state that under requirements of P.A. 74, Michigan P.A. of 1970, the corner points mentioned in lines 1 and 2 above were in conformance with regulations and rules therefore as required in the current manual of survey instructions of the United States Department of the Interior, Bureau of Land Management or by a decree of a Court of Law and /or that the corner points mentioned in lines 3, 4 and 5 above were in conformance with the rules of the Michigan Board of Land Surveyors or by a Decree of a Court of Law; established, re-established, monumented, recovered, found as expressed below:

NOTE: Not more than 2 corners, all in the same town and range, may be recorded on this certificate.

A. Description of original monument and accessories and/or subsequent restoration:


(E4) Quarter corner common to Sections 8 and 9. 1957 - Billy D. Buckler RLS remonumented the corner at a found wood post and from the original BTs. Set 1" pipe with 4" brass cap. 8" J.Pine S14E 58 links, 6" J.Pine N45W 20.5 links.
 (F5) Quarter corner common to Sections 9 and 16. 1960 - Remonumented by Billy D. Buckler RLS from the two original Yellow Pine BTs. Set 1" pipe with 4" brass cap. 7" Red Oak N40W 32 links, 9" Red Oak S12W 48 links.

B. Description of corner evidence found and/or method applied in restoring or reestablishing corner:

(E4) Recovered the 1957 monument in good condition and at record bearing and distance from the NW J.Pine NBT. The SE J.Pine NBT is gone. Also found at record bearing and distance are the remains of the original BTs: Spruce Pine 12 N34W 57 links, a rotting stump with notch still visible, and Yellow Pine 18 S80E 59 links, now a stump with no markings evident.
 (F5) Recovered the 1960 monument in good condition and at record bearing and distance from the remaining 1960 NBT Red Oak NW, now 12" DBH in good condition. The original Yellow Pine BT S67 1/2E 54 links is still evident, a rotting stump with notch visible. Left the monument in place and made new witnesses as described below.

C. Description of monument for corner and accessories established to perpetuate locating the position of the corner:

| | |
|--|--|
| (E4) Fd. 1" ID I.pipe with 4" brass MI Dept. of Conservation cap. Set measuring nails in: 7" J.Pine N16E 51.85' mrkd "1/4S NBT" 8" J.Pine S63E 4.9' do 11" R.Pine S45W 56.7' do 10" J.Pine N37W 13.6' old blazes * | (F5) Fd. 1" ID I.pipe with 4" brass MI Dept. of Conservation cap. Set measuring nails in: 12" R.Oak N38W 21.4' mrkd "1/4S" * 10" J.Pine N01W 35.95' "1/4S NBT" 6" J.Pine S05E 20.2' do 8" J.Pine S66E 45.5' do |
| Bearings are magnetic. Distances are to nail with tag. * denotes 1957 NBT. | Bearings are magnetic. Distances are to nail with tag. * denotes 1960 NBT. |

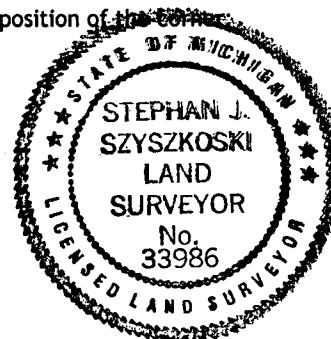

Signed by Stephan J. Szyszkoski
 Surveyor's Michigan License No. 33986

Date 8/3/06