LAND CORNER RECORDATION CERTIFICATE
Filing Requirement of Act 74, Mich. P.A. 1970 as Amended

For corners in

Chippewa (County)

	Located In:	Corner Code #
1. Public Land Survey	T 49N R 6W	F3
	T 49N R 6W	G4
	T ___ R ___	
	S___ T___ R___	
2. Property Controlling	S___ T___ R___	
in Section	S___ T___ R___	
3. Miscellaneous	S___ T___ R___	
Property in Sec.	S___ T___ R___	

Register of Deeds Stamp & File Number

4. Lot No. _____ , Recorded Plat_____

5. Private Claims

G4 Apr 26 2006
F3 May 17 2006

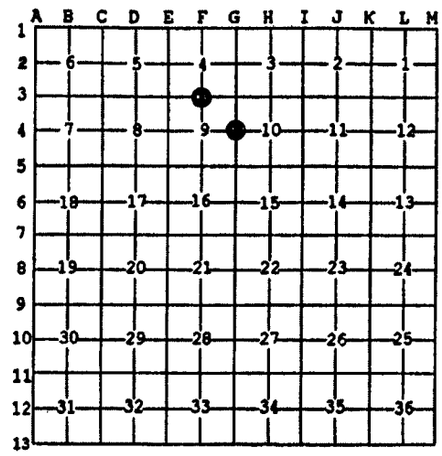

I, Stephan J. Szyszkoski, in a field survey on _____, 20 ____ do hereby state that under requirements of P.A. 74, Michigan P.A. of 1970, the corner points mentioned in lines 1 and 2 above were in conformance with regulations and rules therefore as required in the current manual of survey instructions of the United States Department of the Interior, Bureau of Land Management or by a decree of a Court of Law and /or that the corner points mentioned in lines 3, 4 and 5 above were in conformance with the rules of the Michigan Board of Land Surveyors or by a Decree of a Court of Law; established, re-established, monumented, recovered, found as expressed below:

NOTE: Not more than 2 corners, all in the same town and range, may be recorded on this certificate.

A. Description of original monument and accessories and/or subsequent restoration:

(F3) Quarter corner common to Sections 4 and 9. 1975 - reestablished by Billy D. Buckler RLS midway and on line between Section corners. Set 1"ID iron pipe with 4" aluminum cap. 14" W.Pine N36W 83.5', 6" J.Pine S55E 2.0'.
(G4) Quarter corner common to Sections 9 and 10. 1975 - Reestablished by Billy D. Buckler RLS midway and on line between two Section corners. Set 1" pipe with 4" aluminum cap. No witness trees available.

B. Description of corner evidence found and/or method applied in restoring or reestablishing corner:

(F3) Recovered the 1975 monument in good condition and at record bearing and distance from the 1975 witnesses, the W.Pine in good condition, the J.Pine standing dead. Determined that the monument is 0.7' from the single proportionate position intended and I accept same as a careful and faithful reestablishment of the position of the original corner.
(G4) Recovered the 1975 monument in good condition. Determined that the monument is 38.4' south of the single proportionate position intended in 1975. Did not accept the monument as marking the properly-reestablished position for the corner. Reestablished the corner midway and on line between Section corners 2657.99' north and south. The corner falls in an old beaver meadow. Destroyed the 1975 monument.

C. Description of monument for corner and accessories established to perpetuate locating the position of the corner:

(F3) Fd. 1"ID I.pipe with 4" alum. MDNR cap. Set measuring nails in:
21" W.Pine N34W 83.98' mrkd "1/4S" *
10" R.Pine N87E 17.64' mrkd "1/4S NBT"
8" R.Pine S40W 26.65' do
10" R.pine N49W 30.7' do
Bearings are magnetic. Distances are to nail with tag. * denotes 1975 NBT.

(G4) Set 1"IDx36" I.pipe with 4" alum. MDNR cap. Set measuring nails in:
6" Spruce S47W 68.45' mrkd "1/4S NBT"
3" Tamarack N63E 23.4'
2" Tamarack S50E 30.4'
2" Spruce S82W 22.5'
Bearings are magnetic. Distances are to nail with tag.

STATE OF MICHIGAN
STEPHAN J. SZYSZKOSKI
LAND SURVEYOR
No. 33986
LICENSED LAND SURVEYOR

Signed by Stephan J. Szyszkoski Date 8/3/06

Surveyor's Michigan License No. 33986

For the Michigan Department of Natural Resources, Office of Land and Facilities

FORM APPROVED BY MICHIGAN STATE BOARD OF PROFESSIONAL SURVEYORS, JAN. 28, 1971
Revised May 14, 1975
Revised Jan., 1983
Revised Oct., 1995