

LAND CORNER RECORDATION CERTIFICATE

FILING REQUIREMENT OF ACT 74, MICH. P.A. 1970

Chippewa Co.

2 Corners.

| FOR CORNERS OF-- | LOCATED IN-- | CORNER CODE NUMBER |
|---------------------------------------|---|--------------------|
| 1. PUBLIC LAND SURVEY | T. <u>49</u> N. <u>2</u> , R. <u>7</u> E. <u>W.</u> | J-11, K-11 |
| 2. PROPERTY CONTROLLING IN SECTION | T. _____ N. _____ S., R. _____ E. _____ W. | _____ |
| 3. MISCELLANEOUS PROPERTY IN SECTION | T. _____ N. _____ S., R. _____ E. _____ W. | _____ |
| 4. LOT NO. _____, RECORDED PLAT _____ | | |
| 5. PRIVATE CLAIMS _____ | | |

REGISTER OF DEEDS STAMP AND FILING NUMBER

I, Billy D. Buckler, do hereby certify that under requirements of P.A. 74, Michigan P.A. of 1970, the corner points mentioned in lines 1 and 2 above were, in a field survey on 5-24, 1977, established, re-established, monumented, re-monumented, recovered or restored as expressed below and in conformance with regulations and rules therefore as required in the current manual of survey instructions of the United States Department of the Interior, Bureau of Land Management or by a decree of a court of law. Furthermore, that the corner points mentioned in lines 3, 4 and 5 above were, in a field survey on _____, 19____, found, recovered, restored, established or re-established as expressed below and in conformance with the rules of the Michigan State Board of Registration for Land Surveyors or, by a Decree of a Court of law:

A. Description of original monument and accessories and/or subsequent restoration:

Corners set by Wells Burt D.S. in 1849. Bearings were:

- J-11 1/4 cor. bet. Sec's. 26-35. Y. Pine 14", N86¹/₂°W, 33 lks & Spruce 10", S6°W, 19 lks.
- K-11 Sec. Cor. 25-26-35-36. W. Pine, 24", N75°E, 16 lks. & Maple 6", S38°W, 43 lks.

B. Description of corner evidence found and/or method applied in restoring or re-establishing corner:


- J-11 Replaced corner from original witnesses.
- K-11 Replaced corner from W. Pine bearing tree stump.

C. Description of monument for corner and accessories established to perpetuate locating the position of the corner:

- J-11 Placed 1" pipe with 4" alum. cap at corner. New Bearings: 6" J. Pine, S68°W, 22.4' & 6" R. Pine, N41°W, 21.0'.
- K-11 Placed 1" pipe with 4" alum. cap at corner. New Bearings: 16" R. Pine, N23°E, 48.5' & 12" W. Birch, S51°W, 60.1'.

SIGNED BY Billy D. Buckler DATE 7-31-81
 Billy D. Buckler

SURVEYOR'S MICHIGAN REGISTRATION NO. 8887

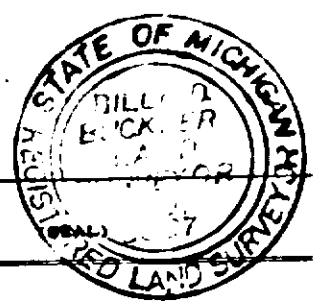

FOR STATE AND UNITED STATES AGENCIES:

SIGNED BY _____ DATE _____
CHIEF OF SURVEY PARTY

APPROVED AND SIGNED BY _____ DATE _____
MICHIGAN REGISTERED LAND SURVEYOR (SEAL)

SURVEYOR'S MICHIGAN REGISTRATION NO. _____