LAND CORNER RECORDATION CERTIFICATE
Filing Requirement of Act 74, Mich. P.A. 1970 as Amended

For corners in

Chippewa
(County)

	Located In:	Corner Code #
1. Public Land Survey	T 49N R 7W	D3
	T___ R___	
	T___ R___	
	S___ T___ R___	
2. Property Controlling	S___ T___ R___	
in Section	S___ T___ R___	
3. Miscellaneous	S___ T___ R___	
Property in Sec.	S___ T___ R___	

Register of Deeds Stamp & File Number

4. Lot No. _____ , Recorded Plat_____

5. Private Claims

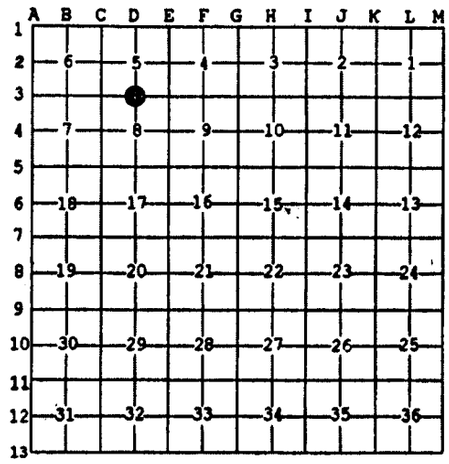

Oct 18 2005

I, Stephan J. Szyszkoski, in a field survey on _____, 20 ____ do hereby state that under requirements of P.A. 74, Michigan P.A. of 1970, the corner points mentioned in lines 1 and 2 above were in conformance with regulations and rules therefore as required in the current manual of survey instructions of the United States Department of the Interior, Bureau of Land Management or by a decree of a Court of Law and /or that the corner points mentioned in lines 3, 4 and 5 above were in conformance with the rules of the Michigan Board of Land Surveyors or by a Decree of a Court of Law; established, re-established, monumented, recovered, found as expressed below:

NOTE: Not more than 2 corners, all in the same town and range, may be recorded on this certificate.

A. Description of original monument and accessories and/or subsequent restoration:

(D3) Quarter corner common to Sections 5 and 8. 1849 - Established by Wells Burt, Deputy Surveyor: "West marked back between Sections 5 & 8... 39.84 Set Tamarack post qr. Section corner. Spruce 8 S55E 97 links, Spruce 8 N30W 57 links. ...79.68 Section corner". Found no subsequent record.

B. Description of corner evidence found and/or method applied in restoring or reestablishing corner:

(D3) Found a 1"ID iron pipe set by an unknown surveyor, said pipe being located 0.88' North of the Section line between monumented corners C3 and E3 and 1.16' West of the position proportionate to the original record. I accept same as the best available evidence of the position of the original corner. I left the pipe in place and drove an aluminum MDNR tablet into the top of it.

C. Description of monument for corner and accessories established to perpetuate locating the position of the corner:

(D3) Fd 1"ID I.pipe. Set 4" alum. MDNR
cap in top. Set measuring nails in:
9" Spruce S34W 15.55' mrkd "1/4S NBT"
8" W.Pine S52E 16.7' do
6" J.Pine N50E 28.55' do
16" W.Pine N10E 26.7' do
Bearings are magnetic. Distances are to
nail with tag.

STATE OF MICHIGAN
STEPHAN J. SZYSZKOSKI
LAND SURVEYOR
No. 33986
LICENSED LAND SURVEYOR

Signed by Stephan J. Szyszkoski Date 2/21/06

Surveyor's Michigan License No. 33986

For the Michigan Department of Natural Resources, Office of Land and Facilities

FORM APPROVED BY MICHIGAN STATE BOARD OF PROFESSIONAL SURVEYORS, JAN. 28, 1971
Revised May 14, 1975
Revised Jan., 1983
Revised Oct., 1995