LAND CORNER RECORDATION CERTIFICATE
Filing Requirement of Act 74, Mich. P.A. 1970 as Amended

For corners in

Chippewa (County)

		Located In:	Corner Code #
1. Public Land Survey		T 49N R 7W	E10
		T___ R___	
		T___ R___	
	S___	T___ R___	
2. Property Controlling	S___	T___ R___	
in Section	S___	T___ R___	
3. Miscellaneous	S___	T___ R___	
Property in Sec.	S___	T___ R___	

Register of Deeds Stamp & File Number

4. Lot No. _____ , Recorded Plat_____

5. Private Claims

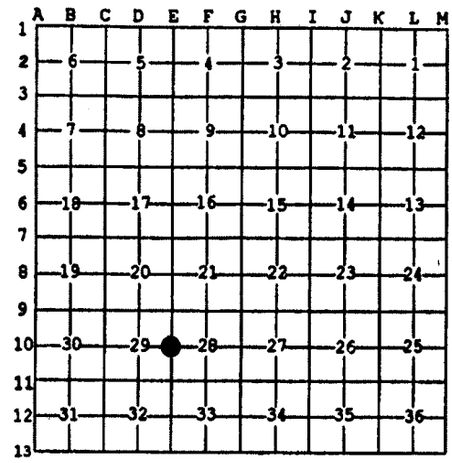

I, Stephan J. Szyszkoski, in a field survey on Aug 29 2005, 20____ do hereby state that under requirements of P.A. 74, Michigan P.A. of 1970, the corner points mentioned in lines 1 and 2 above were in conformance with regulations and rules therefore as required in the current manual of survey instructions of the United States Department of the Interior, Bureau of Land Management or by a decree of a Court of Law and /or that the corner points mentioned in lines 3, 4 and 5 above were in conformance with the rules of the Michigan Board of Land Surveyors or by a Decree of a Court of Law; established, re-established, monumented, recovered, found as expressed below:

NOTE: Not more than 2 corners, all in the same town and range, may be recorded on this certificate.

A. Description of original monument and accessories and/or subsequent restoration:

(E10) Quarter corner common to Sections 28-29. 1849 - Established by Wells Burt, Deputy Surveyor: "North between Sections 28 and 29 ...40.00 Set Tamarack post qr. section corner. Y.Pine 14 S15W 58 links, Y.Pine 14 N84E 20 links". 1971 - Remonumented by Billy D. Buckler, RLS: "This corner replaced at wood post, from remains of two original witnesses; both Y.Pine stumps, bearing S15W 58 links and N84E 20 links. SW stump has remains of bottom blaze and notch in place. Wood post placed by E.A.Sainio, RLS". Set 1" pipe with 4" aluminum cap. 8" Red Oak N12W 3.0', 9" Jack Pine S6E 16.8'.

B. Description of corner evidence found and/or method applied in restoring or reestablishing corner:

(E10) Recovered the 1971 monument in good condition and at record bearing and distance from the 1971 witnesses: The R.Oak in good condition with overgrown, opened blaze. The 1971 record gives this NBT a NW bearing. It is actually located N15E from the corner. The J.Pine NBT is in good condition with old blaze open and iron marks visible. The original BT Y.Pine witnesses were also recovered at record bearing and distance. Both are stumps, the measuring notch being visible on the SW BT, no markings visible on the NE BT.

C. Description of monument for corner and accessories established to perpetuate locating the position of the corner:

(E10) Found 1" I.pipe with 4" alum. MDNR cap. Set measuring nails in:
10" Red Oak N15E 3.4' with old marks *
10" J.Pine S05E 17.3' do *
9" J.Pine S47E 15.6' mrkd "1/4S NBT"
8" J.Pine S35W 11.9' do
Bearings are magnetic. Distances are to nail with tag. * denotes 1971 NBT.

STATE OF MICHIGAN
STEPHAN J. SZYSZKOSKI
LAND SURVEYOR
No. 33986
LICENSED LAND SURVEYOR

Signed by Stephan J. Szyszkoski Date 2/21/06

Surveyor's Michigan License No. 33986

For the Michigan Department of Natural Resources, Office of Land and Facilities

FORM APPROVED BY MICHIGAN STATE BOARD OF PROFESSIONAL SURVEYORS, JAN. 28, 1971
Revised May 14, 1975
Revised Jan., 1983
Rervised Oct., 1995