LAND CORNER RECORDATION CERTIFICATE
Filing Requirement of Act 74, Mich. P.A. 1970 as Amended

For corners in

Chippewa (County)

	Located In:	Corner Code #
1. Public Land Survey	T 49N R 7W	G1
	T 50N R 7W	G13 (same corner)
	T___ R___	
	S___ T___ R___	
2. Property Controlling	S___ T___ R___	
in Section	S___ T___ R___	
3. Miscellaneous	S___ T___ R___	
Property in Sec.	S___ T___ R___	

Register of Deeds Stamp & File Number

4. Lot No. _____ , Recorded Plat_____

5. Private Claims

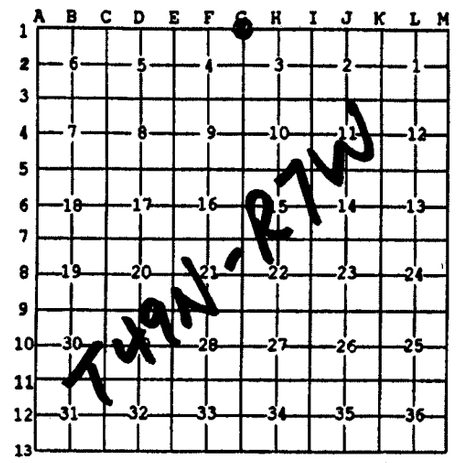

Aug 29 2005

I, Stephan J. Szyszkoski, in a field survey on _____, 20 ____ do hereby state that under requirements of P.A. 74, Michigan P.A. of 1970, the corner points mentioned in lines 1 and 2 above were in conformance with regulations and rules therefore as required in the current manual of survey instructions of the United States Department of the Interior, Bureau of Land Management or by a decree of a Court of Law and /or that the corner points mentioned in lines 3, 4 and 5 above were in conformance with the rules of the Michigan Board of Land Surveyors or by a Decree of a Court of Law; established, re-established, monumented, recovered, found as expressed below:

NOTE: Not more than 2 corners, all in the same town and range, may be recorded on this certificate.

A. Description of original monument and accessories and/or subsequent restoration:

(G1) Corner common to Sections 3-4 T49N-R07W and Sections 33-34 T50N-R07W. 1840 - Established by Wm.A.Burt, Deputy Surveyor: "West on South side of Section 34 ...80.00 Set post corner of Sections 33&34. Fir 6 N63E 18 links, Birch 7 N6W 13 links". Oct 24 1939 - Note presumably by Marcus Schaaf, RLS: "NE BT is a (7") W.P. 15" with very good upper face scribes plain and good lower face - Broke off and down. NW hole. New bearings W.P. stp N11E 64.5, W.P. stp S31E 71, W.P. stp S73E 1.36". 1952 - Remonumented by Dean C. DeLaMater, RLS: "This corner was pointed out to me by B. McTiver, District Forester, of Newberry. Corner had been previously located and perpetuated by Marcus Schaaf, RLS". Set 1" pipe with 4" brass cap. 8" J.Pine N74W 23 links, 12" J.Pine S66E 37 links.

B. Description of corner evidence found and/or method applied in restoring or reestablishing corner:

(G1) Recovered the 1952 monument in good condition and at record bearing and distance from the two 1952 J. Pine NBTs, both in good condition with overgrown blazes. Left the monument in place and made new witnesses as described below.

C. Description of monument for corner and accessories established to perpetuate locating the position of the corner:

(G1) Found 1"ID I.pipe with 4" brass MI Dept. of Conservation cap. Set measuring nails in:
11" J.Pine N73W 15.0' mrkd "S33" *
16" J.Pine S68E 25.0' "S3" *
14" J.Pine N27E 2.4' "S34 NBT"
12" J.Pine S22W 32.1' "S4 NBT"
found "t" fence post S82E approx. 44.5' distant. Bearings are magnetic.
Distances are to nail with tag.

STATE OF MICHIGAN
STEPHAN J. SZYSZKOSKI
LAND SURVEYOR
No. 33986
LICENSED LAND SURVEYOR

Signed by Stephan J. Szyszkoski Date 2/21/06

Surveyor's Michigan License No. 33986

For the Michigan Department of Natural Resources, Office of Land and Facilities

FORM APPROVED BY MICHIGAN STATE BOARD OF PROFESSIONAL SURVEYORS, JAN. 28, 1971
Revised May 14, 1975
Revised Jan., 1983
Revised Oct., 1995