

**LAND CORNER RECORDATION CERTIFICATE**  
**Filing Requirement of Act 74, Mich. P.A. 1970 as Amended**

For corners in

Chippewa  
 (County)

Located In:

Corner Code #

1. Public Land Survey	T <u>49N</u> R <u>7W</u>	H1
	T <u>50N</u> R <u>7W</u>	H13 (same corner)
	T _____ R _____	_____
2. Property Controlling in Section	S _____ T _____ R _____	_____
	S _____ T _____ R _____	_____
3. Miscellaneous Property in Sec.	S _____ T _____ R _____	_____
	S _____ T _____ R _____	_____

Register of Deeds Stamp & File Number

4. Lot No. \_\_\_\_\_, Recorded Plat \_\_\_\_\_  
 5. Private Claims \_\_\_\_\_

Oct 27 2005

I, Stephan J. Szyszkoski, in a field survey on \_\_\_\_\_, 20 \_\_\_\_ do hereby state that under requirements of P.A. 74, Michigan P.A. of 1970, the corner points mentioned in lines 1 and 2 above were in conformance with regulations and rules therefore as required in the current manual of survey instructions of the United States Department of the Interior, Bureau of Land Management or by a decree of a Court of Law and /or that the corner points mentioned in lines 3, 4 and 5 above were in conformance with the rules of the Michigan Board of Land Surveyors or by a Decree of a Court of Law; established, re-established, monumented, recovered, found as expressed below:

**NOTE:** Not more than 2 corners, all in the same town and range, may be recorded on this certificate.

A. Description of original monument and accessories and/or subsequent restoration:


(H1) Quarter corner common to Section 3 T49N-R07W and Section 34 T50N-R07W. 1840 - Established by Mm. A. Burt, Deputy Surveyor: "West on South side of Section 34 ...40.00 Set qr. section post. Aspen 8 N64E 15 links, Fir 6 N82W 15 links. ...80.00 Set post corner of Sections 33&34". Found no subsequent record.

B. Description of corner evidence found and/or method applied in restoring or reestablishing corner:

(H1) The original post and accessories were not recovered. Found no evidence of the position of the original corner on the ground. Reestablished the corner on the Township line and midway between monumented Section corners 2657.95' East and West.

C. Description of monument for corner and accessories established to perpetuate locating the position of the corner:

(H1) Set 1"IDx36" I.pipe with 4" alum.  
 MDNR cap. Set measuring nails in:  
 3" Spruce N30E 45.7' mrd "1/4S NBT"  
 20" W.Pine S76E 64.0' do  
 3" Balsam S50E 35.65' do  
 6" W.Pine S10E 63.6' do  
 Bearings are magnetic. Distances are to nail with tag.

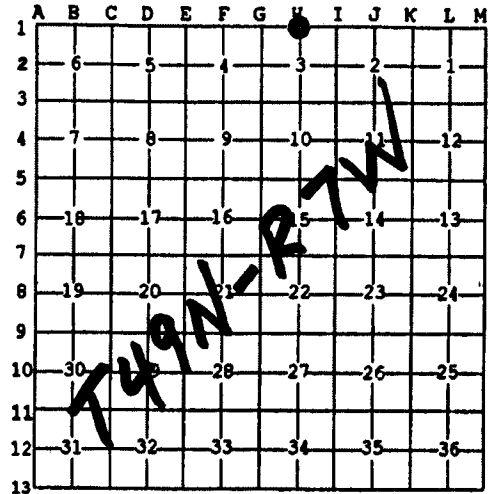

Signed by Stephan J. Szyszkoski  
 Surveyor's Michigan License No. 33986

Date 2/21/06

For the Michigan Department of Natural Resources, Office of Land and Facilities