


SECTION 6,
T.50N. R.5W.
CHIPPEWA CO.

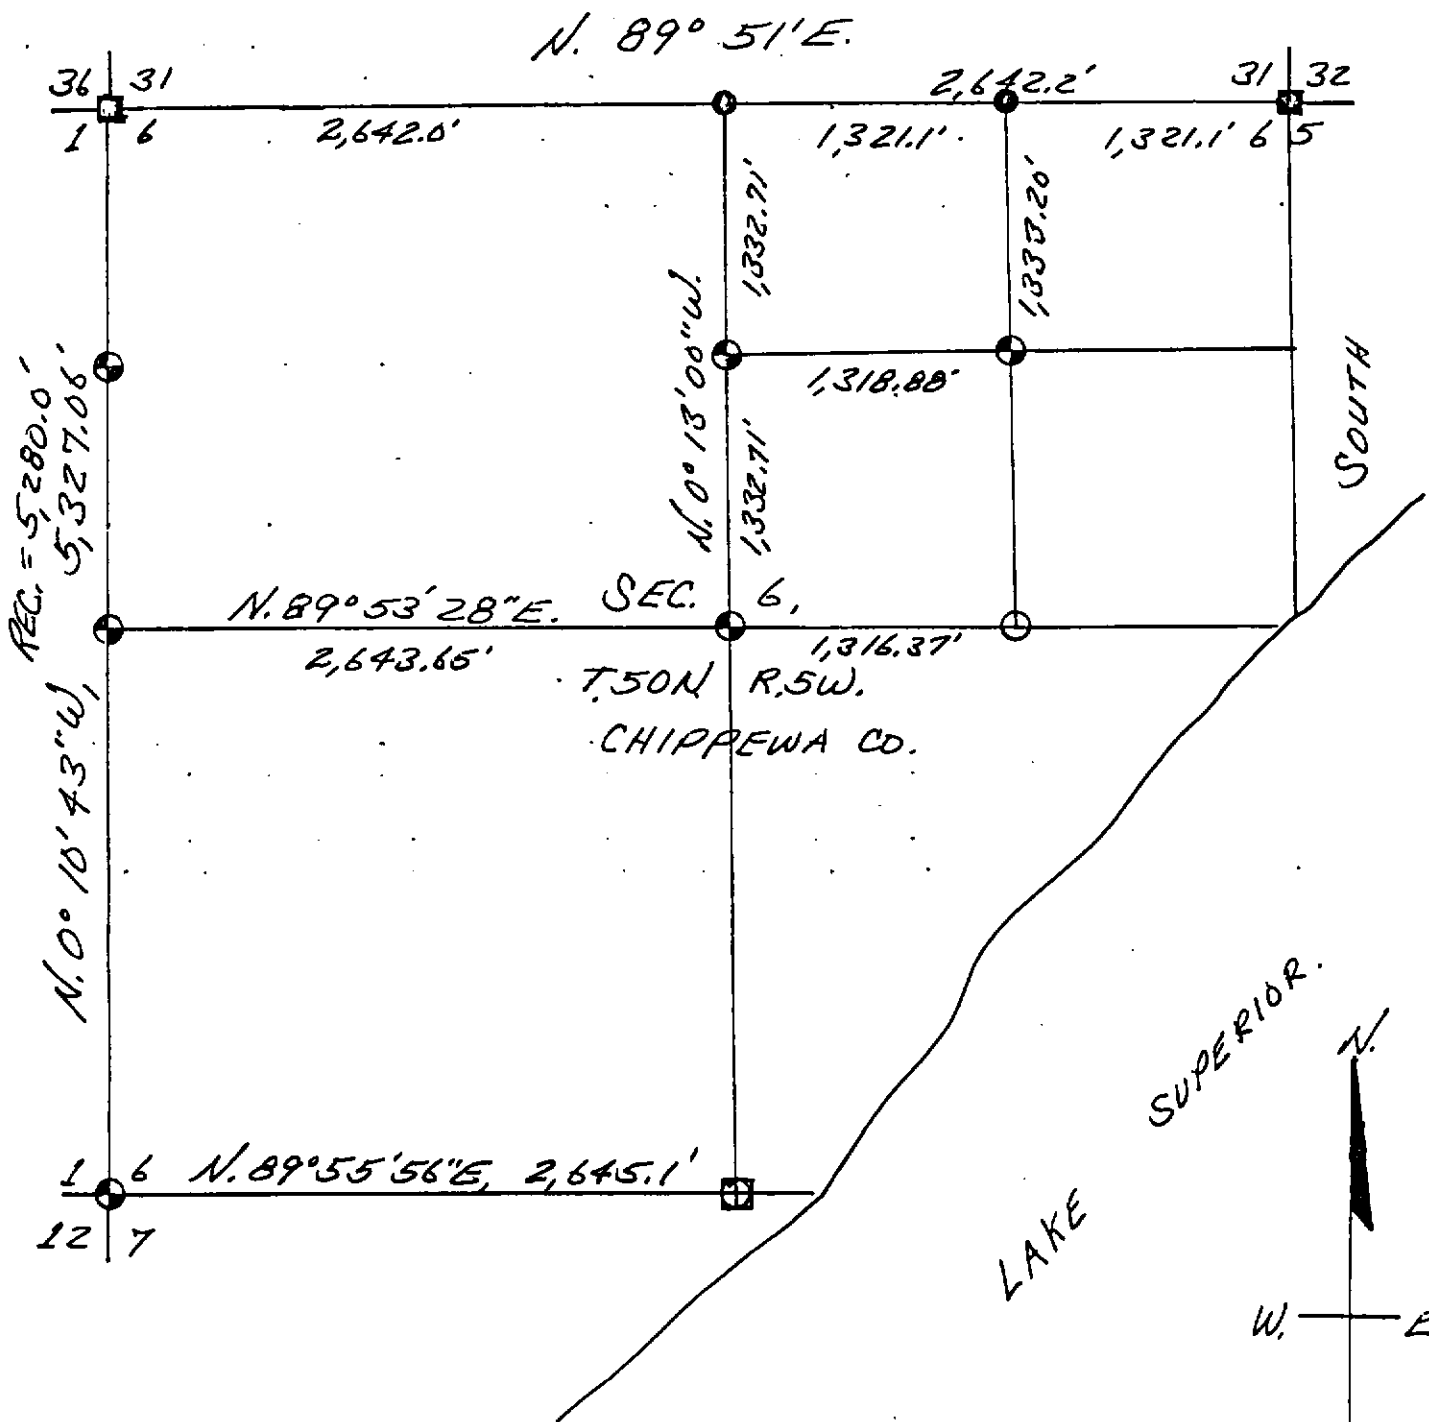

9-19-75
BDB