

# LAND CORNER RECORDATION CERTIFICATE

## FILING REQUIREMENT OF ACT 74, MICH. P.A.1970

Chippewa Co.

Six Corners.

FOR CORNERS OF--:	LOCATED IN--:	CORNER CODE NUMBER
1. PUBLIC LAND SURVEY _____	T. <u>50</u> N. <u>X</u> , R. <u>6</u> W.	H-11
2. PROPERTY CONTROLLING IN SECTION <u>27</u>	, T. <u>50</u> N. <u>X</u> , R. <u>6</u> W.	2-Sec.27 6-Sec.27 5-Sec.27 13-Sec.27 16-Sec.27
3. MISCELLANEOUS PROPERTY IN SECTION _____	, T. _____ N. _____, R. _____ E. _____	
4. LOT NO. _____, RECORDED PLAT _____		
5. PRIVATE CLAIMS _____		

REGISTER OF DEEDS STAMP AND FILING NUMBER

I, Billy D. Buckler do hereby certify that under requirements of P.A. 74, Michigan P.A. of 1970, the corner points mentioned in lines 1 and 2 above (identified with circles on index code diagram-over) were, in a field survey on 7/26 1974, established, re-established, monumented, re-monumented, recovered or restored as expressed below and in conformance with regulations and rules therefore as required in the current manual of survey instructions of the United States Department of the Interior, Bureau of Land Management or by a decree of a court of law. Furthermore, that the corner points mentioned in lines 3, 4 and 5 above were, in a field survey on \_\_\_\_\_ 19\_\_\_\_, found, recovered, restored, established or re-established as expressed below and in conformance with the rules of the Michigan State Board of Registration for Land Surveyors or, by a Decree of a Court of law:

**A. Description of original monument and accessories and/or subsequent restoration:**

- 2-Sec.27 East 1/16 Corner, on North side Section 27.
- 6-Sec.27 North-East 1/16 Corner, Section 27.
- 5-Sec.27 North 1/16 Corner, Section 27.
- 13-Sec.27 South-East 1/16 Corner, Section 27.
- H-11 Quarter Corner bet. Sec's 27-34, set by Wells Burt, D.S. 1849. Bearings were:  
W. Pine 10", S45°W, 19 lks. and W. Pine 12", N25°E, 27 lks.
- 16-Sec.27 East 1/16 Corner, on South side Section 27.

**B. Description of corner evidence found and/or method applied in restoring or re-establishing corner:**


- 2-Sec.27 Corner placed midway bet. Sec. Cor. to East and  $\frac{1}{4}$  Cor. to West.
- 6-Sec.27 Corner placed at intersection of lines, quartering the North-East  $\frac{1}{4}$  Section.
- 5-Sec.27 Corner placed midway bet.  $\frac{1}{4}$  Cor. to North and Center cor. to South.
- 13-Sec.27 Corner placed at intersection of lines, quartering the South-East  $\frac{1}{4}$  Section.
- H-11 Replaced Cor. from two original bearing tree stumps, in proper position. Found notch and overgrowth on both stumps. Both were cut approx. 30 years ago. This  $\frac{1}{4}$  Cor. is not midway on the mile, bet. Sec. Cors, being 2,646.4' from Corner to West.
- 16-Sec.27 Corner placed midway and on line bet. Sec. Cor. to East and  $\frac{1}{4}$  Corner to West.

**C. Description of monument for corner and accessories established to perpetuate locating the position of the corner:**

- Placed 1" pipe with 4" aluminium cap at all corners.
- 2-Sec.27 New Bearings: 10" J. Pine, N62°W, 16.6' and 8" J. Pine, N68°E, 26.1'
  - 6-Sec.27 New Bearings: 6" R. Pine, N50°W, 21.1' and 8" W. Pine, S27°E, 9.1'
  - 5-Sec.27 New Bearings: 4" R. Pine, N71°E, 6.8' and 6" R. Pine, S2°E, 24.4'
  - 13-Sec.27 New bearings: 13" R. Pine, N83°W, 4.9' and 12" R. Pine, N80°E, 27.7'
  - H-11 New Bearings: 9" R. Pine, N68°E, 2.7' and 9" R. Pine, N52°W, 3.3'
  - 16-Sec.27 New Bearings: 10" W. Pine, S39°E, 22.2' and 8" R. Oak, N36°W, 6.0'

SIGNED BY Billy D. Buckler DATE 10-30-74

SURVEYOR'S MICHIGAN REGISTRATION NO. 8887

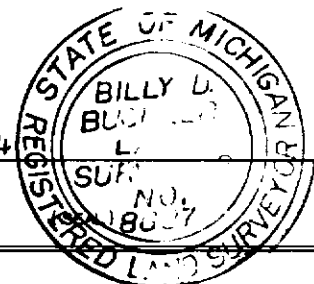

FOR STATE AND UNITED STATES AGENCIES:

SIGNED BY \_\_\_\_\_ DATE \_\_\_\_\_  
CHIEF OF SURVEY PARTY

APPROVED AND SIGNED BY \_\_\_\_\_ DATE \_\_\_\_\_  
MICHIGAN REGISTERED LAND SURVEYOR

(SEAL)

SURVEYOR'S MICHIGAN REGISTRATION NO. \_\_\_\_\_