


SECTION 1,
T. 50 N. R. 6 W.

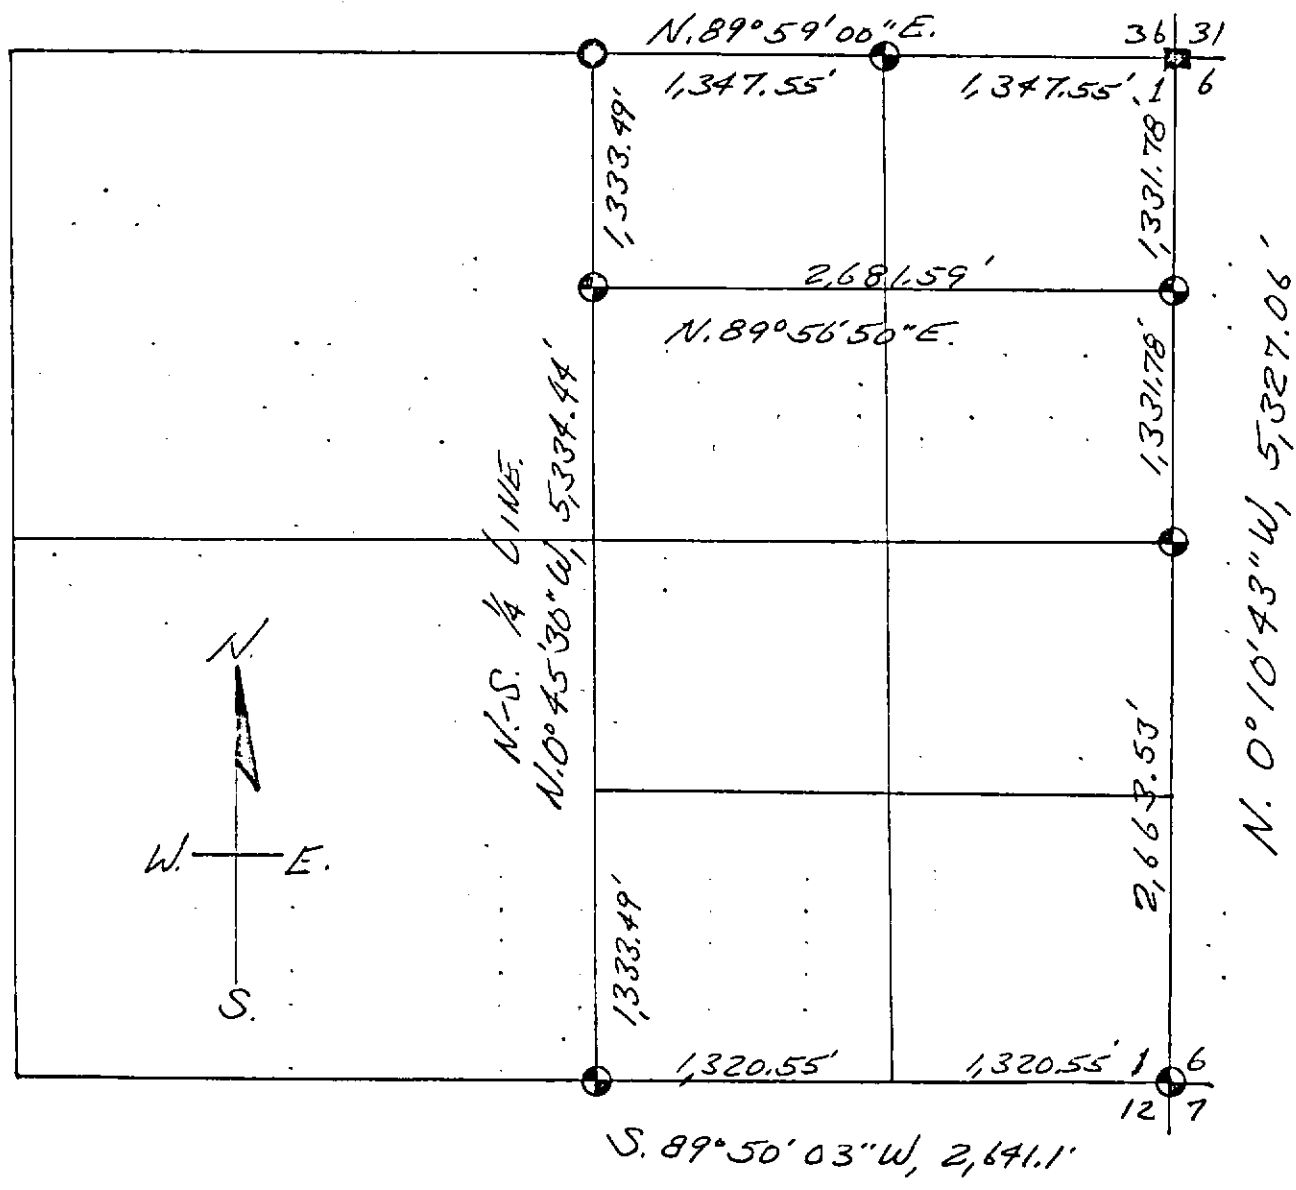

9-19-75
R.D.R.