


LAKE SUPERIOR

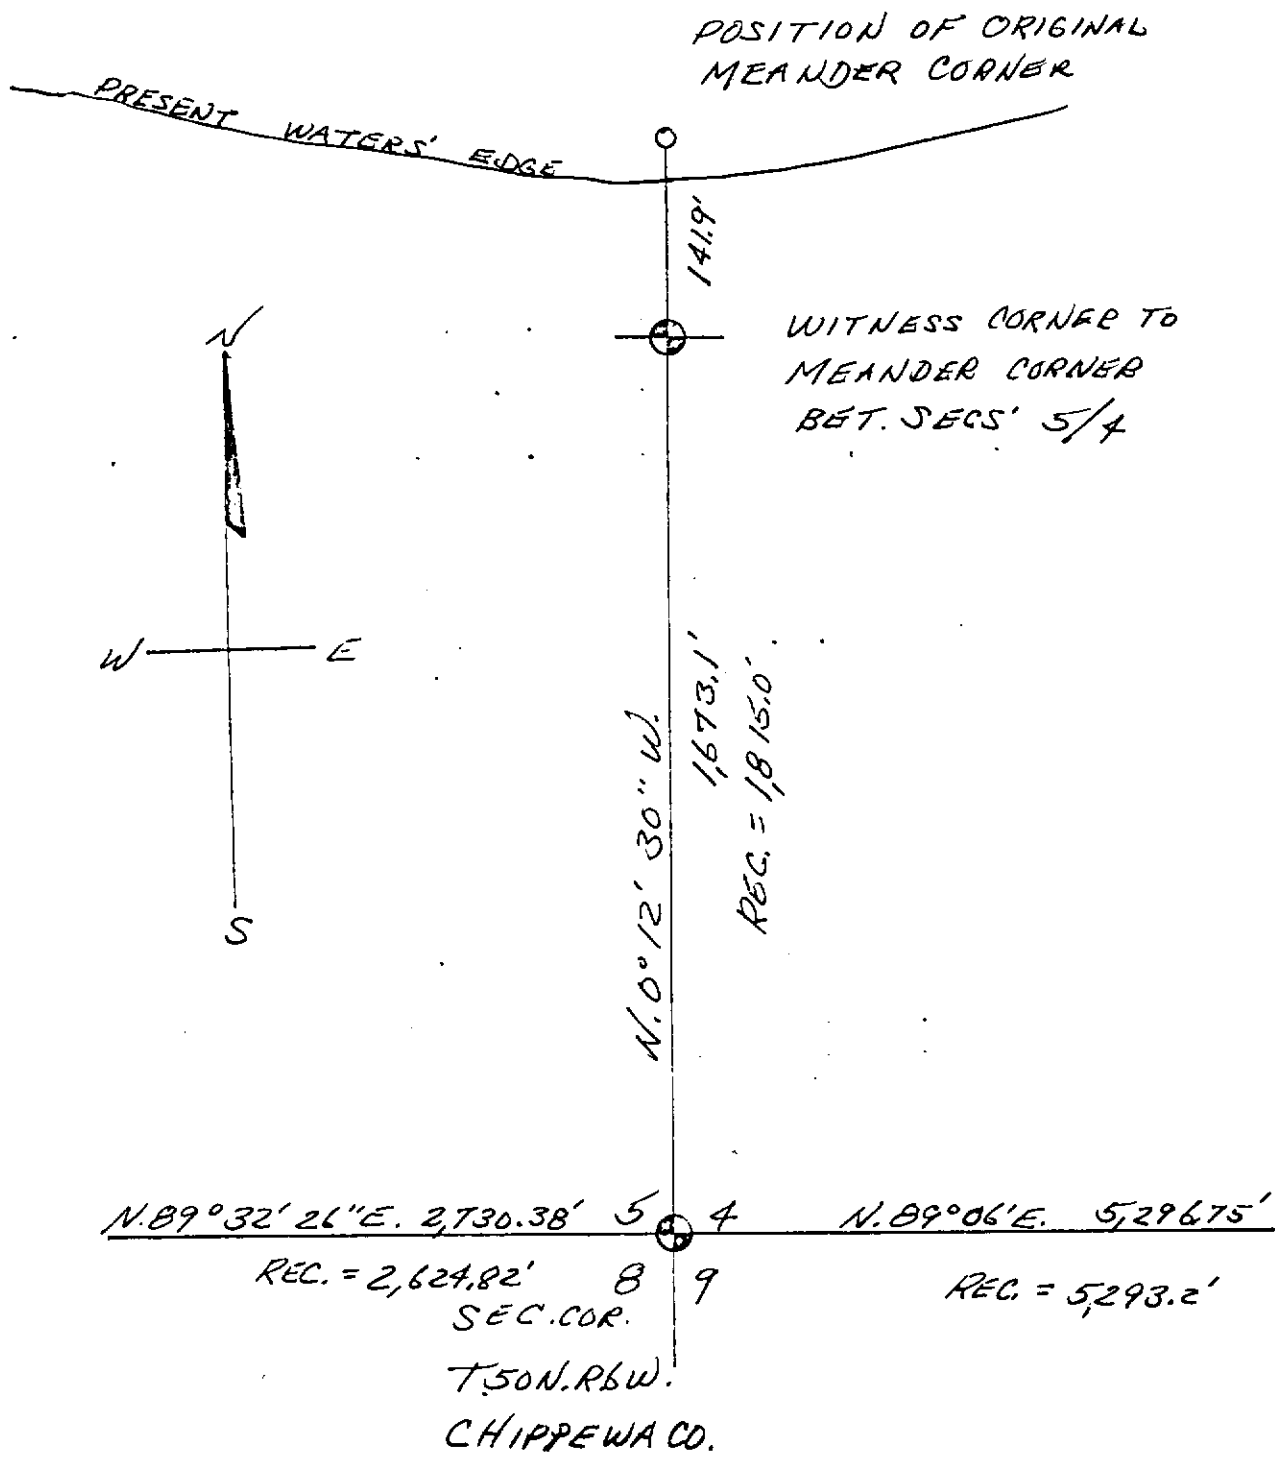

9-19-95

B.D.B.