


LAKE SUPERIOR POSITION OF ORIGINAL MEANDER COR.

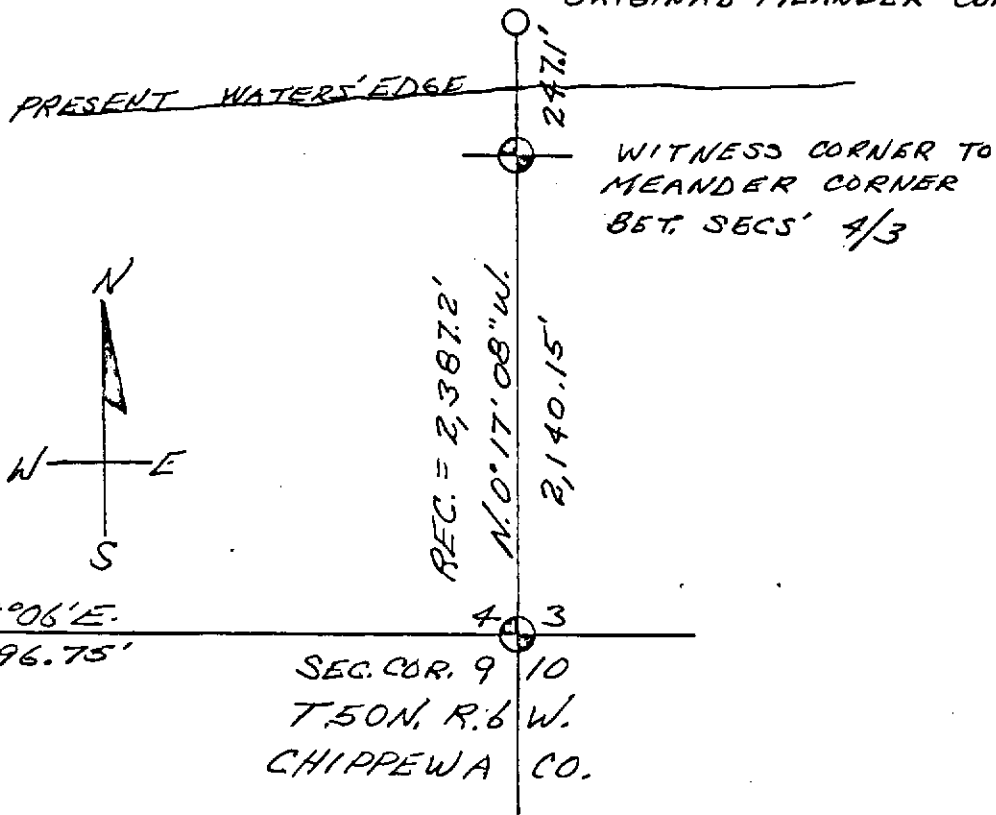

BDB  
9/19/75