

LAND CORNER RECORDATION CERTIFICATE

FILING REQUIREMENT OF ACT 74, MICH. P.A.1970

Chippewa Co.

Two Corners.

FOR CORNERS OF--:	LOCATED IN--:	CORNER CODE NUMBER
1. PUBLIC LAND SURVEY _____	T. <u>50</u> ^{N.} / _{S.} , R. <u>6</u> ^{K.} / _{W.}	2-A
2. PROPERTY CONTROLLING IN SECTION <u>6</u>	T. <u>50</u> ^{N.} / _{S.} , R. <u>6</u> ^{K.} / _{W.}	14-Sec.6
3. MISCELLANEOUS PROPERTY IN SECTION _____	T. _____ ^{N.} / _{S.} , R. _____ ^{E.} / _{W.}	_____
4. LOT NO. _____, RECORDED PLAT _____		
5. PRIVATE CLAIMS _____		

REGISTER OF DEEDS STAMP AND FILING NUMBER

I, Billy D. Buckler, do hereby certify that under requirements of P.A. 74, Michigan P.A. of 1970, the corner points mentioned in lines 1 and 2 above were, in a field survey on 8-18, 1975, established, re-established, monumented, re-monumented, recovered or restored as expressed below and in conformance with regulations and rules therefore as required in the current manual of survey instructions of the United States Department of the Interior, Bureau of Land Management or by a decree of a court of law. Furthermore, that the corner points mentioned in lines 3, 4 and 5 above were, in a field survey on _____, 19____, found, recovered, restored, established or re-established as expressed below and in conformance with the rules of the Michigan State Board of Registration for Land Surveyors or, by a Decree of a Court of law:

A. Description of original monument and accessories and/or subsequent restoration:
 Meander Corner placed by Wells Burt, D.S. in 1849. Bearings were: Tam. 6, S2&3/4°E, 3.69'.
 Tam. 5, S2°W, 3.58 chs.
 2-A Witness corner to Meander Corner, on shore of Lake Superior, bet. Sec's. 5-6.
 14-Sec.6 South 1/16 Corner, bet. Sec's. 5-6.


B. Description of corner evidence found and/or method applied in restoring or re-establishing corner:
 2-A Placed witness corner to Meander Corner by proportionate measure to East and West along the lake. Witness corner lies 162.0' South of original Meander Corners record position. Lake shore has moved southward due to erosion by wind and high water.
 14-Sec.6 Placed 1/16 Cor. at record distance form Sec. Cor. to South.

C. Description of monument for corner and accessories established to perpetuate locating the position of the corner:
 Placed 1" pipe with 4" aluminium cap at both corners.
 2-A Witnesses: 18" W. Pine, S51°W, 78.8' & 22" W. Pine, South, 64.5'
 14-Sec.16 Witnesses: 24" W. Pine, S26½°W, 29.0' & 14" R. Pine, N84°E, 66.4'

NOTE: See Sketch On Back.

SIGNED BY Billy D. Buckler DATE 8-25-75

SURVEYOR'S MICHIGAN REGISTRATION NO. 8887

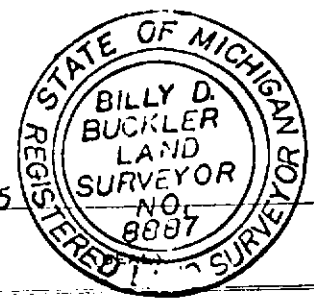

FOR STATE AND UNITED STATES AGENCIES:
 SIGNED BY _____ DATE _____
CHIEF OF SURVEY PARTY

APPROVED AND SIGNED BY _____ DATE _____
MICHIGAN REGISTERED LAND SURVEYOR (SEAL)

SURVEYOR'S MICHIGAN REGISTRATION NO. _____