

LAKE
SUPERIOR


POSITION OF
ORIGINAL MEANDER
CORNER, ON RANGE LINE.

REC. = 960.3'

PRESENT

WATERS' EDGE.

1/4 CORNER, WEST
SIDE, SEC. 6, T. 50N. R. 6W.

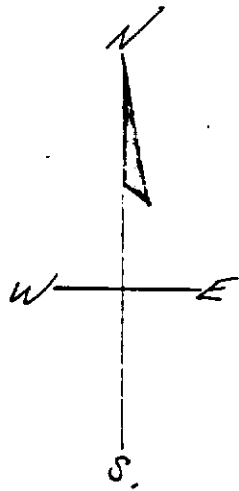

SEC. 6.

REC. = 2,640.
N. 0° 13' 33" E. 2,640.0'
LINE R's 6 AND 7 WEST.

SEC. COR. 12

S. 89° 43' 28" E. 2,664.03'

REC. = 2,671.02'

T. 50N
R's 6-7W
CHIPPEWA CO.

RANGE

9-19-75

B.D.B