LAND CORNER RECORDATION CERTIFICATE
Filing Requirement of Act 74, Mich. P.A. 1970 as Amended

For corners in

Chippewa (County)

		Located In:	Corner Code #
1. Public Land Survey		T 50N R 6W	G12
		T___ R___	
		T___ R___	
	S___	T___ R___	
2. Property Controlling	S___	T___ R___	
in Section	S___	T___ R___	
3. Miscellaneous	S___	T___ R___	
Property in Sec.	S___	T___ R___	

Register of Deeds Stamp & File Number

4. Lot No. _____ , Recorded Plat_____
5. Private Claims

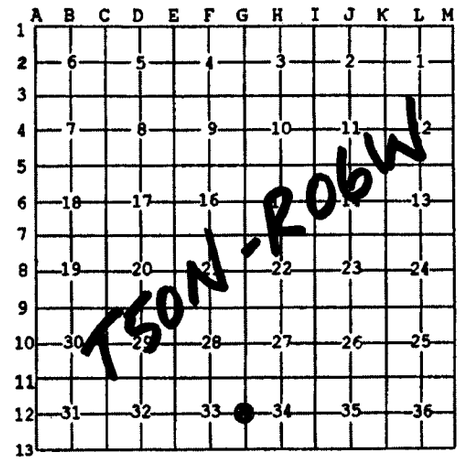

Jun 11 2007

I, Stephan J. Szyszkoski, in a field survey on _____, 20 ____ do hereby state that under requirements of P.A. 74, Michigan P.A. of 1970, the corner points mentioned in lines 1 and 2 above were in conformance with regulations and rules therefore as required in the current manual of survey instructions of the United States Department of the Interior, Bureau of Land Management or by a decree of a Court of Law and /or that the corner points mentioned in lines 3, 4 and 5 above were in conformance with the rules of the Michigan Board of Land Surveyors or by a Decree of a Court of Law; established, re-established, monumented, recovered, found as expressed below:

NOTE: Not more than 2 corners, all in the same town and range, may be recorded on this certificate.

A. Description of original monument and accessories and/or subsequent restoration:

(G12) Quarter corner common to Sections 33 and 34. 1979 - Billy D. Buckler RLS recovered and accepted a 1/2" iron set by Corey Hughes RLS 20706. Replaced iron with 1"ID pipe with 4" aluminum cap. 10" J.Pine N23W 18.5', 10" J.Pine N75W 16.4', 10" J.Pine S04E 10.5'

B. Description of corner evidence found and/or method applied in restoring or reestablishing corner:

(G12) Recovered the 1979 monument in good condition. The 1979 witnesses were not recovered. The position of the monument is 0.23' east and 0.02' north of the proportionate position between Section corners. I accept the monument as a perpetuation of the position of the Hughes monument and a careful and faithful reestablishment of the position of the original corner.

C. Description of monument for corner and accessories established to perpetuate locating the position of the corner:

(G12) Found 1"ID I.pipe with 4" alum.
MDNR cap. Set measuring nails in:
10" W.Pine S65E 85.7' mrkd "1/4S NBT"
15" J.Pine N07E 49.55' do
6" J.Pine S46W 59.1' do
4" J.Pine N50W 88.7' do
Bearings are magnetic. Distances are to nail with MDNR tag.

STATE OF MICHIGAN
STEPHAN J. SZYSZKOSKI
LAND SURVEYOR
No. 33986
LICENSED LAND SURVEYOR

Signed by Stephan J. Szyszkoski Date 6/28/07

Surveyor's Michigan License No. 33986

For the Michigan Department of Natural Resources, Office of Land and Facilities

FORM APPROVED BY MICHIGAN STATE BOARD OF PROFESSIONAL SURVEYORS, JAN. 28, 1971
Revised May 14, 1975
Revised Jan., 1983
Rervised Oct., 1995