LAND CORNER RECORDATION CERTIFICATE
Filing Requirement of Act 74, Mich. P.A. 1970 as Amended

For corners in

Chippewa (County)

	Located In:			Corner Code #
1. Public Land Survey		T____	R____	
		T____	R____	
		T____	R____	
	S____	T____	R____	
2. Property Controlling	S 33	T 50N	R 6W	12
in Section	S 33	T 50N	R 6W	1/64 E. of 12
3. Miscellaneous	S____	T____	R____	
Property in Sec.	S____	T____	R____	

Register of Deeds Stamp & File Number

4. Lot No. _____ , Recorded Plat_____
5. Private Claims

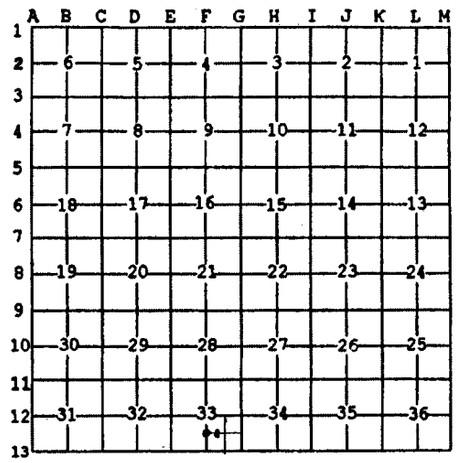

Jun 12 2007

I, Stephan J. Szyszkoski, in a field survey on _____, 20 ____ do hereby state that under requirements of P.A. 74, Michigan P.A. of 1970, the corner points mentioned in lines 1 and 2 above were in conformance with regulations and rules therefore as required in the current manual of survey instructions of the United States Department of the Interior, Bureau of Land Management or by a decree of a Court of Law and /or that the corner points mentioned in lines 3, 4 and 5 above were in conformance with the rules of the Michigan Board of Land Surveyors or by a Decree of a Court of Law; established, re-established, monumented, recovered, found as expressed below:

NOTE: Not more than 2 corners, all in the same town and range, may be recorded on this certificate.

A. Description of original monument and accessories and/or subsequent restoration:

(12-Sec. 33) South 1/16 corner, Section 33. Not established in the original survey. 1981 - recorded by Billy D. Buckler RLS: "Placed corner midway bet. center corner and the South 1/4 corner".
(1/64 E. of #12) the C-W-SE 1/64 corner, Section 33, being the SE corner of the SW1/4 of the NW1/4 of the SE1/4 of Section 33. Not established in the original survey.

B. Description of corner evidence found and/or method applied in restoring or reestablishing corner:

(12-Sec. 33) Found but did not accept the 1981 monument of record. Established the corner midway and on a straight line between Quarter corner 1330.86' south and the intersection of 1/4 lines of Section 33 1330.86' north. Examination of the 1981 notes of Billy D. Buckler show that the Center 1/4 corner of the Section was determined in 1981 by an improper method. Therefore I did not accept the position of the 1/16 corner. Removed the 1981 monument and placed it at the reestablished position. The 1981 monument was recovered S14W, 11.2' from the position monumented.
(1/64) Established the corner midway and on a straight line between 1/16 corner numbers 12 and 13, 656.36' west and east. The position for the corner falls in the Betsy River and was not monumented. Established a Witness Corner on the 1/64 line 25.00' north of the corner position. From the WC, the top of the northerly river bank is 12' south.

C. Description of monument for corner and accessories established to perpetuate locating the position of the corner:

(12) Set 1"IDx36" I.pipe with 4" alum. MDNR cap. Set measuring nails in:
9" Maple N27W 6.55' mrkd "S1/16 BT"
8" Maple S80W 9.55' do
6" Balsam S02W 15.88' do
7" Maple N56E 11.45' do
Bearings are magnetic. Distances are to nail with MDNR tag.

(1/64) Set 1"IDx36" I.pipe w/4" alum. MDNR cap for a Witness Corner. Set measuring nails in :
9" Maple S72W 14.7' mrkd "WC BT"
10" Maple in clump S20W 11.61' do
12" Maple N66W 9.1' do
7" Maple N06E 9.12' do
Bearings are magnetic. Distances are to nail with MDNR tag.

STATE OF MICHIGAN
STEPHAN J. SZYSZKOSKI
LAND SURVEYOR
No. 33986
LICENSED LAND SURVEYOR

Signed by Stephan J. Szyszkoski Date 6/28/07

Surveyor's Michigan License No. 33986

For the Michigan Department of Natural Resources, Office of Land and Facilities

FORM APPROVED BY MICHIGAN STATE BOARD OF PROFESSIONAL SURVEYORS, JAN. 28, 1971
Revised May 14, 1975
Revised Jan., 1983
Revised Oct., 1995