

# LAND CORNER RECORDATION CERTIFICATE

FILING REQUIREMENT OF ACT 74, MICH. P.A.1970

Chippewa Co.

5 Corners.

FOR CORNERS OF--	LOCATED IN--	CORNER CODE NUMBER
1. PUBLIC LAND SURVEY _____	T. 50 <sup>N.</sup> <del>S.</del> , R. 7 <sup>E.</sup> <del>W.</del>	k-10, L-9, L-10 F-11
2. PROPERTY CONTROLLING IN SECTION 28 _____	T. 50 <sup>N.</sup> <del>S.</del> , R. 7 <sup>E.</sup> <del>W.</del>	1-Sec.28
3. MISCELLANEOUS PROPERTY IN SECTION _____	T. _____ <sup>N.</sup> <del>S.</del> , R. _____ <sup>E.</sup> <del>W.</del>	
4. LOT NO. _____, RECORDED PLAT _____		
5. PRIVATE CLAIMS _____		

REGISTER OF DEEDS STAMP AND FILING NUMBER

I, Billy D. Buckler, do hereby certify that under requirements of P.A. 74, Michigan P.A. of 1970, the corner points mentioned in lines 1 and 2 above were, in a field survey on 11-13 & 10-17, 1975, established, re-established, monumented, re-monumented, recovered or restored as expressed below and in conformance with regulations and rules therefore as required in the current manual of survey instructions of the United States Department of the Interior, Bureau of Land Management or by a decree of a court of law. Furthermore, that the corner points mentioned in lines 3, 4 and 5 above were, in a field survey on \_\_\_\_\_, 19\_\_\_\_, found, recovered, restored, established or re-established as expressed below and in conformance with the rules of the Michigan State Board of Registration for Land Surveyors or, by a Decree of a Court of law:

A. Description of original monument and accessories and/or subsequent restoration:  
Corners placed by wells Burt, D.S. in 1849.

- K-10 Quarter Corner bet. Sec's. 25-26. Bearings were: S.Pine 10", S29°W, 22 lks. and S.Pine 6", N44°E, 10 lks.
- L-9 Quarter Corner bet. Sec's. 24-25. Bearings were: S.Pine 12", N49°W, 46 lks. and S.Pine 12", S4°E, 15 lks.
- L-10 Center Corner, of Section 25.
- F-11 Quarter Corner bet. Sec's. 28-33. Bearings were: W.Birch 8", N45°E, 23 lks. and S.Pine 7", S51°W, 36 lks.

1-Sec.28 West 1/16 Corner, on Southside, Sec. 28.

B. Description of corner evidence found and/or method applied in restoring or re-establishing corner:

- K-10 Corner placed midway and on line bet. two Sec. Cors.
- L-9 Corner placed at 3/4" pipe, which is midway and on line bet. two Sec. Cors.
- L-10 Corner placed at intersection of lines connecting opposite  $\frac{1}{4}$  Corners.
- F-11 Corner re-established midway and on line bet. two Sec. Cors. No evidence of original corner.

1-Sec.28 Corner placed midway bet. Sec. Cor. to West and Quarter Corner to East.


C. Description of monument for corner and accessories established to perpetuate locating the position of the corner:  
Placed 1" pipe with 4" aluminium cap at all corners.

- K-10 New Bearings: 12" R. Pine, N68°W, 50.2' and 8" J. Pine, N25°E, 13.7'
- L-9 New Bearings: 10" R. Pine, N19°E, 17.8' and 6" R. Pine, N19°W, 15.9'
- L-10 New Bearings: 8" R. Pine, S46°E, 21.1' and 10" J. Pine, N46°E, 27.9'
- F-11 New Bearings: 18" R. Pine, N86°E, 74.2' and 8" J. Pine, S100°E, 11.1'
- 1-Sec.28 New Bearings: 18" R. Pine, N53°W, 64.5' and 8" J. Pine, N60°E, 11.1'

*See Sketch on Reverse side.*

SIGNED BY Billy D. Buckler DATE 12-17-75

SURVEYOR'S MICHIGAN REGISTRATION NO. 8887

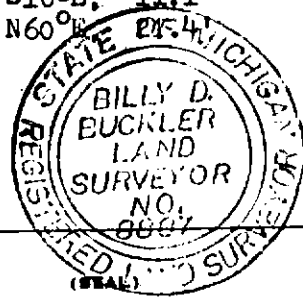

FOR STATE AND UNITED STATES AGENCIES:

SIGNED BY \_\_\_\_\_ DATE \_\_\_\_\_  
CHIEF OF SURVEY PARTY

APPROVED AND SIGNED BY \_\_\_\_\_ DATE \_\_\_\_\_  
MICHIGAN REGISTERED LAND SURVEYOR (SEAL)

SURVEYOR'S MICHIGAN REGISTRATION NO. \_\_\_\_\_