

Chippewa Co.

LAND CORNER RECORDATION CERTIFICATE

FILING REQUIREMENT OF ACT 74, MICH. P.A.1970
Chippewa Co. 2 Corners.

FOR CORNERS OF--	LOCATED IN--	CORNER CODE NUMBER
1. PUBLIC LAND SURVEY_____	T. _____ N. _____ S., R. _____ E. _____ W. _____	_____
2. PROPERTY CONTROLLING IN SECTION <u>9</u>	, T. <u>50</u> N. _____ S., R. <u>7</u> E. _____ W. _____	6-Sec.9 9-Sec.9
3. MISCELLANEOUS PROPERTY IN SECTION _____	, T. _____ N. _____ S., R. _____ E. _____ W. _____	_____
4. LOT NO. _____, RECORDED PLAT _____		
5. PRIVATE CLAIMS _____		

REGISTER OF DEEDS STAMP AND FILING NUMBER

I, Billy D. Buckler, do hereby certify that under requirements of P.A. 74, Michigan P.A. of 1970, the corner points mentioned in lines 1 and 2 above were, in a field survey on 8-30, 19 79, established, re-established, monumented, re-monumented, recovered or restored as expressed below and in conformance with regulations and rules therefore as required in the current manual of survey instructions of the United States Department of the Interior, Bureau of Land Management or by a decree of a court of law. Furthermore, that the corner points mentioned in lines 3, 4 and 5 above were, in a field survey on _____, 19 _____, found, recovered, restored, established or re-established as expressed below and in conformance with the rules of the Michigan State Board of Registration for Land Surveyors or, by a Decree of a Court of law:

A. Description of original monument and accessories and/or subsequent restoration:

6-Sec.9 Northeast 1/16 Corner of Section 9.

9-Sec.9 East 1/16 Corner of Section 9.

B. Description of corner evidence found and/or method applied in restoring or re-establishing corner:

6-Sec.9 Placed corner at computed location of center of NE Quarter Section.

9-Sec.9 Placed corner midway bet. Center Corner, and the East 1/4 corner.

C. Description of monument for corner and accessories established to perpetuate locating the position of the corner:


Placed 1" pipe with 4" aluminium cap at both corners.

6-Sec.9 Bearings: 7" S. Maple, N34°W, 36.5' and 8" S. Maple, S62°W, 33.9' and 8" R. Maple, S70°E, 37.4'

9-Sec.9 Bearings: 8" S. Maple, N32°E, 10.9' and 12" S. Maple, S65°W, 12.5' and 18" S. Maple, S44°E, 24.2'. Corner lies 150' South of road.

SIGNED BY Billy D. Buckler DATE 9-10-79

SURVEYOR'S MICHIGAN REGISTRATION NO. 8887

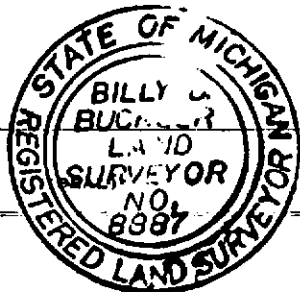

FOR STATE AND UNITED STATES AGENCIES:

SIGNED BY _____ DATE _____

CHIEF OF SURVEY PARTY

APPROVED AND SIGNED BY _____ DATE _____

MICHIGAN REGISTERED LAND SURVEYOR

(SEAL)

SURVEYOR'S MICHIGAN REGISTRATION NO. _____