

LAND CORNER RECORDATION CERTIFICATE
Filing Requirement of Act 74, Mich. P.A. 1970

For corners in
Chippewa
 (County)

Located In: _____ Corner Code # _____

| | | |
|------------------------------------|--------------------------|------------|
| 1. Public Land Survey | T <u>50N</u> R <u>7W</u> | <u>G11</u> |
| | T <u>50N</u> R <u>7W</u> | <u>G12</u> |
| | T _____ R _____ | _____ |
| | T _____ R _____ | _____ |
| 2. Property Controlling in Section | S _____ T _____ R _____ | _____ |
| | S _____ T _____ R _____ | _____ |
| 3. Miscellaneous Property in Sec. | S _____ T _____ R _____ | _____ |
| | S _____ T _____ R _____ | _____ |

Register of Deeds Stamp & File Number

4. Lot No. _____, Recorded Plat _____
 5. Private Claims _____

Jan 12 2006

I, Stephan J. Szyszkoski, in a field survey on _____, 19____ do hereby state that under requirements of P.A. 74, Michigan P.A. of 1970, the corner points mentioned in lines 1 and 2 above were in conformance with regulations and rules therefore as required in the current manual of survey instructions of the United States Department of the Interior, Bureau of Land Management or by a decree of a Court of Law and /or that the corner points mentioned in lines 3, 4 and 5 above were in conformance with the rules of the Michigan Board of Land Surveyors or by a Decree of a Court of Law; established, re-established, monumented, recovered, found as expressed below:

| | | | | | | | | | | | | | |
|----|----|---|----|---|----|---|----|---|----|---|----|---|---|
| 1 | A | B | C | D | E | F | G | H | I | J | K | L | M |
| 2 | 6 | | 5 | | 4 | | 3 | | 2 | | 1 | | |
| 3 | | | | | | | | | | | | | |
| 4 | 7 | | 8 | | 9 | | 10 | | 11 | | 12 | | |
| 5 | | | | | | | | | | | | | |
| 6 | 18 | | 17 | | 16 | | 15 | | 14 | | 13 | | |
| 7 | | | | | | | | | | | | | |
| 8 | 19 | | 20 | | 21 | | 22 | | 23 | | 24 | | |
| 9 | | | | | | | | | | | | | |
| 10 | 30 | | 29 | | 28 | | 27 | | 26 | | 25 | | |
| 11 | | | | | | | | | | | | | |
| 12 | 31 | | 32 | | 33 | | 34 | | 35 | | 36 | | |
| 13 | | | | | | | | | | | | | |

NOTE: Not more than 2 corners, all in the same town and range, may be recorded on this certificate.

A. Description of original monument and accessories and/or subsequent restoration:


(G11) Corner common to Sections 27-28-33-34. 1959 - Remonumented from the stumps of the original Y.Pine BTs by Billy D. Buckler RLS. Set 1" pipe with 4" brass cap. 9" J.Pine N22W 20 links, 9" J.Pine S72E 23 links, 9" J.Pine S32W 29 links.
 (G12) Quarter corner common to Sections 33 and 34. 1959 - Corner remonumented by Billy D. Buckler RLS at the position of an old wood post and Spruce Pine OBT S41E 23 links. Set 1" pipe with 4" brass cap. 8" J.Pine N37E 14.5 links, 8" J.Pine S46E 16 links, 6" J.Pine N74W 15 links.

B. Description of corner evidence found and/or method applied in restoring or reestablishing corner:

(G11) Recovered the 1959 monument in good condition and at record bearing and distance from the 1959 witness trees: the J.Pine NW in good condition, the J.Pine SE standing dead, and the J.Pine SW a cut stump. No evidence remains of the original Y.Pine BTs. Left the monument in place and made new witnesses as described below.
 (G12) Recovered the 1959 monument in good condition but without the brass cap, at record bearing and distance from the 1959 witnesses: The J.Pines SE and NW are in good condition, the J.Pine NE is dead. Left the monument in place and made new witnesses. Installed a new alum. cap on the monument.

C. Description of monument for corner and accessories established to perpetuate locating the position of the corner:

| | |
|---|---|
| (G11) Found 1" ID I.pipe with 4" brass MI Dept. of Conservation cap. Set measuring nails in: 12" J.Pine N22W 13.25' old blazes * 11" J.Pine N82W 36.25' mrkd "S28 NBT" 5" R.Pine S40W 9.13' "S33 NBT" 6" J.Pine N66E 28.25' "S27 NBT" Bearings are magnetic. Distances are to nail with tag. * denotes 1959 NBT. | (G12) Fd. 1" ID I.pipe, set 4" alum. MDNR cap in it. Set measuring nails in: 9" J.Pine S38E 10.8' old blazes * 7" J.Pine N78W 9.6' do * 21" W.Pine S54W 45.37' mrkd "1/4S NBT" 6" J.Pine S03E 28.06' do Bearings are magnetic. Distances are to nail with tag. * denotes 1959 NBT. |
|---|---|

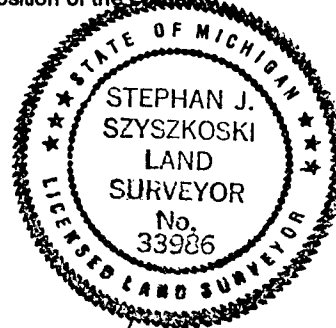

Signed by Stephan J. Szyszkoski
 Surveyor's Michigan License No. 33986

Date 8/8/06