

**LAND CORNER RECORDATION CERTIFICATE**  
**Filing Requirement of Act 74, Mich. P.A. 1970**

For corners in Chippewa <hr/> (County)	Located In:	Corner Code #
1. Public Land Survey	T ___ R ___ T ___ R ___ T ___ R ___ T ___ R ___	_____ _____ _____ _____
2. Property Controlling in Section	S 34 T 50NR 7W S 34 T 50NR 7W	9 6
3. Miscellaneous Property in Sec.	S ___ T ___ R ___ S ___ T ___ R ___	_____ _____

Register of Deeds Stamp & File Number

4. Lot No. \_\_\_\_\_, Recorded Plat \_\_\_\_\_  
 5. Private Claims \_\_\_\_\_

Apr 16 2006

I, Stephan J. Szyszkoski, in a field survey on \_\_\_\_\_, 19\_\_\_\_ do hereby state that under requirements of P.A. 74, Michigan P.A. of 1970, the corner points mentioned in lines 1 and 2 above were in conformance with regulations and rules therefore as required in the current manual of survey instructions of the United States Department of the Interior, Bureau of Land Management or by a decree of a Court of Law and /or that the corner points mentioned in lines 3, 4 and 5 above were in conformance with the rules of the Michigan Board of Land Surveyors or by a Decree of a Court of Law; established, re-established, monumented, recovered, found as expressed below:

NOTE: Not more than 2 corners, all in the same town and range, may be recorded on this certificate.

1	A	B	C	D	E	F	G	H	I	J	K	L	M
2	6		5		4		3		2		1		
3													
4	7		8		9		10		11		12		
5													
6	18		17		16		15		14		13		
7													
8	19		20		21		22		23		24		
9													
10	30		29		28		27		26		25		
11													
12	31		32		33		34		35		36		
13													

**A. Description of original monument and accessories and/or subsequent restoration:**


- (9-Sec. 34) East 1/16 corner, Section 34. Not established in the original survey. Found no subsequent record.
- (6-Sec. 34) Northeast 1/16 corner, Section 34. Not established in the original survey. Found no subsequent record.

**B. Description of corner evidence found and/or method applied in restoring or reestablishing corner:**

- (9-Sec. 34) Established the corner midway and on a straight line between Quarter corner 1313.90' East and Center of Section 1313.90' West.
- (6-Sec. 34) Established at the intersection of straight lines connecting opposite 1/16 corners.

**C. Description of monument for corner and accessories established to perpetuate locating the position of the corner:**

- |   |  |
|---|--|
| (9) Set 1"IDx36" I.pipe with 4" alum. MDNR cap. Set measuring nails in:<br>7" J.Pine N66E 17.77' mrkd "E1/16 BT"<br>11" J.Pine S78E 7.58' do<br>11" J.Pine S12W 17.25' do<br>6" J.Pine N01W 40.65' do<br>Fd. 1" pipe S08E 20.77'<br>Bearings are magnetic. Distances to trees are to nail with tag. | (6) Set 1"IDx36" I.pipe with 4" alum. MDNR cap. Set measuring nails in:<br>12" R.Pine S86E 13.75' mrkd "NE1/16 BT"<br>11" J.Pine S38E 14.0' do<br>12" J.Pine S30W 27.5' do<br>10" J.Pine N70W 4.85' do<br>Fd. 1" pipe S20W 28.81'<br>Bearings are magnetic. Distances to trees are to nail with tag. |
|---|--|

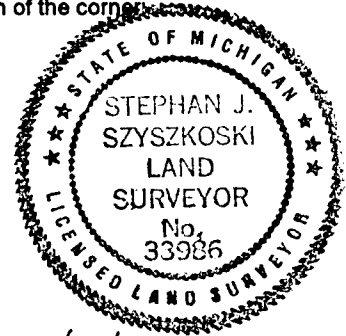

Signed by Stephan J. Szyszkoski Date 8/8/06  
 Surveyor's Michigan License No. 33986