

LAND CORNER RECORDATION CERTIFICATE
Filing Requirement of Act 74, Mich. P.A. 1970

For corners in
Chippewa

(County)

Located In:

Corner Code #

- | | | | | | | | | |
|------------------------------------|---|-----------|---|------------|-------|-----------|-------|-----------|
| 1. Public Land Survey | T | _____ | R | _____ | _____ | | | |
| | T | _____ | R | _____ | _____ | | | |
| | T | _____ | R | _____ | _____ | | | |
| | T | _____ | R | _____ | _____ | | | |
| 2. Property Controlling in Section | S | <u>34</u> | T | <u>50N</u> | R | <u>7W</u> | _____ | <u>14</u> |
| | S | <u>35</u> | T | <u>50N</u> | R | <u>7W</u> | _____ | <u>11</u> |
| 3. Miscellaneous Property in Sec. | S | _____ | T | _____ | R | _____ | _____ | _____ |
| | S | _____ | T | _____ | R | _____ | _____ | _____ |

Register of Deeds Stamp & File Number

4. Lot No. _____, Recorded Plat _____
 5. Private Claims _____

11 Jun 20 2006
 14 Jan 12 2006

I, Stephan J. Szyszkoski, in a field survey on _____, 19____ do hereby state that under requirements of P.A. 74, Michigan P.A. of 1970, the corner points mentioned in lines 1 and 2 above were in conformance with regulations and rules therefore as required in the current manual of survey instructions of the United States Department of the Interior, Bureau of Land Management or by a decree of a Court of Law and /or that the corner points mentioned in lines 3, 4 and 5 above were in conformance with the rules of the Michigan Board of Land Surveyors or by a Decree of a Court of Law; established, re-established, monumented, recovered, found as expressed below:

NOTE: Not more than 2 corners, all in the same town and range, may be recorded on this certificate.

A	B	C	D	E	F	G	H	I	J	K	L	M
1												
2	6	5	4	3	2	1						
3												
4	7	8	9	10	11	12						
5												
6	18	17	16	15	14	13						
7												
8	19	20	21	22	23	24						
9												
10	30	29	28	27	26	25						
11												
12	31	32	33	34	35	36						
13												

A. Description of original monument and accessories and/or subsequent restoration:


- (14-Sec. 34) South 1/16 corner between Sections 34 and 35. Not established in the original survey. Found no subsequent record.
 (11-Sec. 35) Southwest 1/16 corner, Section 35. Not established in the original survey. Found no subsequent record.

B. Description of corner evidence found and/or method applied in restoring or reestablishing corner:

- (14-Sec. 34) Established the corner midway and on a straight line between Section corner 1323.10' South and Quarter corner 1323.10' North. The corner falls on the south side of a trail road and the monument was set flush with the ground surface.
 (11-Sec. 35) Established the corner at the intersection of straight lines connecting opposite 1/16 corners.

C. Description of monument for corner and accessories established to perpetuate locating the position of the corner:

- | | |
|--|---|
| (14) Set 1"IDx36" I.pipe with 4" alum. MDNR cap, flush. Set meas. nails in:
8" Maple N29W 35.7' mrkd "S1/16 BT"
20" W.Pine S73W 40.9' do
5" W.Birch S17E 16.1' do
6" W.Birch S50E 17.3' do
Fd. 1" pipe S31E 13.66'
Bearings are magnetic. Distances to trees ape to nail with tag. | (11) Set 1"IDx36" I.pipe with 4" alum. MDNR cap. Set measuring nails in:
6" Balsam N30E 4.75' mrkd "SW1/16 BT"
5" Hemlock N87E 10.7' do
7" Maple S60E 4.3' do
13" Maple S80W 31.9' do
Fd. 2" pipe N80E 17.07'
Bearings are magnetic. Distances to trees are to nail with tag. |
|--|---|

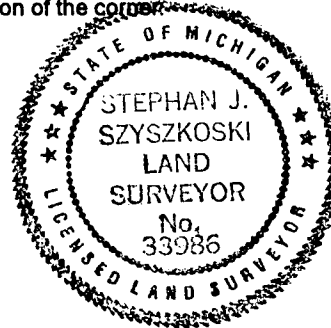

Signed by Stephan J. Szyszkoski
 Surveyor's Michigan License No. 33986

Date 8/8/06