

SURVEY & REMONUMENTATION

JAN 23 1998

CLARE COUNTY REMONUMENTATION

SECTION

LAND CORNER RECORDATION CERTIFICATE Filing Requirement of Act 74, Mich. P.A. 1970

For corners in

| | | |
|---------------------------------------|-------------------------|---------------|
| CLARE | Located In: | Corner Code # |
| (County) | | |
| 1. Public Land Survey | T 17N R 5W | D-13 |
| | T _____ R _____ | _____ |
| | T _____ R _____ | _____ |
| | T _____ R _____ | _____ |
| 2. Property Controlling in Section | S _____ T _____ R _____ | _____ |
| | S _____ T _____ R _____ | _____ |
| 3. Miscellaneous Property in Sec. | S _____ T _____ R _____ | _____ |
| | S _____ T _____ R _____ | _____ |

RECEIVED
 # 255-97
 97 DEC 30 PM 2:20
 REGISTER OF DEEDS
 CLARE COUNTY
 CAROL A. McAULAY

Register of Deeds Stamp & File Number

4. Lot No. _____, Recorded Plat _____
 5. Private Claims _____

I, MARK R. ROBISON, in a field survey on Dec 15, 1997 do hereby state that under requirements of P.A. 74, Michigan P.A. of 1970, the corner points mentioned in lines 1 and 2 above were in conformance with regulations and rules therefore as required in the current manual of survey instructions of the United States Department of the Interior, Bureau of Land Management or by a decree of a Court of Law and for that the corner points mentioned in lines 3, 4 and 5 above were in conformance with the rules of the Michigan Board of Land Surveyors or by a Decree of a Court of Law; established, re-established, monumented, recovered, found as expressed below:

NOTE: Not more than 2 corners, all in the same town and range, may be recorded on this certificate.

| | A | B | C | D | E | F | G | H | I | J | K | L | M |
|----|----|---|----|---|----|---|----|---|----|---|----|---|---|
| 1 | | | | | | | | | | | | | |
| 2 | 6 | | 5 | | 4 | | 3 | | 2 | | 1 | | |
| 3 | | | | | | | | | | | | | |
| 4 | 7 | | 8 | | 9 | | 10 | | 11 | | 12 | | |
| 5 | | | | | | | | | | | | | |
| 6 | 18 | | 17 | | 16 | | 15 | | 14 | | 13 | | |
| 7 | | | | | | | | | | | | | |
| 8 | 19 | | 20 | | 21 | | 22 | | 23 | | 24 | | |
| 9 | | | | | | | | | | | | | |
| 10 | 30 | | 29 | | 28 | | 27 | | 26 | | 25 | | |
| 11 | | | | | | | | | | | | | |
| 12 | 31 | | 32 | | 33 | | 34 | | 35 | | 36 | | |
| 13 | | | | | | | | | | | | | |

A. Description of original monument and accessories and/or subsequent restoration:

1837 Hodgson
 Set 1/4 Section Post
 Wit-Beech 10° N55E 30
 Pine 14° N20W 18

1850 Burt
 Resurvey of part of T16N, R5W

circa 1900-CSR 6-32
 Wit-W. P. Stump 16 N82E 9
 W. P. Stump 16 S3W 39

B. Description of corner evidence found and/or method applied in restoring or reestablishing corner:

Found two irons (5/8" x 36") 19.0 feet apart (Average GLO falling per original GLO notes is 19.80 feet with Standard Corner West of Closing Corner-Average GLO falling per Burt's resurvey is 2.64 feet with Standard Corner West of Closing Corner). An old woven wire fence runs South from the West iron and a single strand barb wire runs North from the East iron which is opposite of GLO notes. Distance between C-13 & E-13 is 5436.58 or 156.58 overrun. SPM will place the corner 56 feet East of the single strand barb wire running North. D-13 to C-13 is 2718.29 feet. It was determined by the peer review that the best position of the corner is single proportion measurement 2718.29 feet, East of C-13. Found no other evidence of the corner.

APPROVED LAND CORNER
 P.A. 345 of 1990
 Clare County


See dossier for detailed report.

Chairman Paul S. Lopp

C. Description of monument for corner and accessories established to perpetuate locating the position of the corner:

D-13: Set 5/8" x 36" rod with Clare County Remonumentation Cap marked P.S.#27458 at SPM between C-13 and E-13. Accepted as the proper method of establishing the lost corner.

Witnesses: Set 5/8" Iron & cap
 N10°E 23.39 - Nail & Tag in 8" Oak
 N65°W 26.05 - Nail & Tag in 6" Maple
 S30°E 29.96 - Nail & Tag in 8" Oak
 S70°W 33.23 - Nail & Tag in 6" Oak S. side
 West 4.95 Isabella County Remon cap

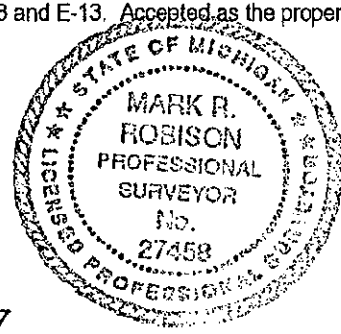

Signed by Mark R. Robison
 Surveyor's Michigan License No. 27458

Date 12-22-97