

SURVEY &
REMONUMENTATION

MAR 24 2000

LAND CORNER RECORDATION CERTIFICATE
Filing Requirement of Act 74, Mich. P.A. 1970
Clare County Remonumentation

SECTION

199900009783
Filed for Record in
CLARE COUNTY MICHIGAN
CAROL MCAULAY
On 11-10-1999 At 01:30 pm.
LAND CORNER 9.00
OR Liber 2 Page 62 - 62

For Corners in
Clare

(County)

Located In: Corner Code#:

- 1. Public Land Survey T. 17N R. 5W E-5
T. _____ R. _____
T. _____ R. _____
- 2. Public Controlling S. _____ T. _____ R. _____
in Section S. _____ T. _____ R. _____
- 3. Miscellaneous S. _____ T. _____ R. _____
Property in Section S. _____ T. _____ R. _____
- 4. Lot No. _____, Recorded Plat _____
- 5. Private Claims _____

Instrument Liber Page
199900009783 OR 2 62

373-99

Register of Deeds Stamp & File Number

I, Mark R. Robison, in a field survey on August 24, 1999, do hereby certify that under requirements of P.A. 74, Michigan P.A. of 1970, the corner points mentioned in lines 1 and 2 above were in conformance with regulations and rules therefore as required in the current manual of survey instructions of the United States Department of the Interior, Bureau of Land Management or by a decree of a Court of Law and/or that the corner points mentioned in lines 3, 4 and 5 above were in conformance with the rules of the Michigan Board of Land Surveyors or by a Decree of a Court of Law, established, re-established, monumented, re-monumented, recovered, found as expressed below.

NOTE: Not more than 2 corners, all in the same town and range, may be recorded on this certificate.

	A	B	C	D	E	F	G	H	I	J	K	L	M
2	6	5	4	3	2	1							
3													
4	7	8	9	10	11	12							
5													
6	18	17	16	15	14	13							
7													
8	19	20	21	22	23	24							
9													
10	30	29	28	27	26	25							
11													
12	31	32	33	34	35	36							
13													

A. Description of original monument and accessories and/or subsequent restoration:

1837 Nicholson
Set Post Cor Secs. 8, 9, 16, & 17
Beech 9' S15E 27
Beech 8' N32W 05

Circa 1900, CSR 6-
Pg. 8, 9, 16, & 17
Maple 20 N55E 12
Beech 8 N32W 5
1976 Fluharty, (132) 2-193
Fd Chisled "X" in Large Rock
at end of fence to West
N65W 14.13 24" Maple
S75W 3.39 15" Maple
S30E 26.62 9" W. Birch


1970 MSHD, Project #18024
Chisled "X" in Large Rock
S85W 3.33 9" Hickory
N60W 14.37 20" Maple
N50E 25.45 17" Elm
1976 Fluharty LCRC #263
Same as (132) 2-193

B. Description of corner evidence found and/or method applied in restoring or re-establishing corner:
See dossier for detailed report.

Fd 3.3' (E-W) x 2.0' (N-S) rock outcrop w/ chisled "X" in S.W. corner. Fd 1" sq. bolt 0.75' N.W. Accepted "X" in rock. Fd old fence West. MSHD meas. 2640.92 West and 2633.79 East. Fd two 1970 witnesses and three 1976 witnesses.

C. Description of monument for corner and accessories established to perpetuate locating the position of the corner:
Accepted chisled "X" in large rock for Clare Co. Remon Monument. Accepted as best available evidence of the accepted position of the corner.

Witnesses:
N608E 13.81 Set N & T in 6" Hickory
S24°E 26.78 Set N & T in large Birch (OBT)
S70°W 3.90 Set N & T in 22" Hickory (OBT)
N50°W 14.37 Set N & T in 32" Maple (OBT)

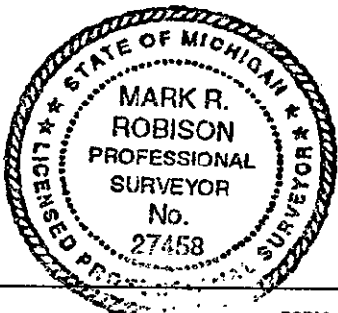

APPROVED LAND CORNER
P.A. 345 of 1990
Clare County

Chairman Paul B. Laska
Date 9-29-99

Signed by Mark R. Robison
Surveyor's Michigan License No. 27458

Date 11-8-99