

MAR 24 2000

LAND CORNER RECORDATION CERTIFICATE  
Filing Requirement of Act 74, Mich. P.A. 1970  
Clare County Remonumentation

SECTION

For Corners in

Clare

(County)

Located In:

Corner Code#:

- 1. Public Land Survey T. 17N R. 5W E-7  
T. \_\_\_\_\_ R. \_\_\_\_\_  
T. \_\_\_\_\_ R. \_\_\_\_\_
- 2. Public Controlling S. \_\_\_\_\_ T. \_\_\_\_\_ R. \_\_\_\_\_  
in Section S. \_\_\_\_\_ T. \_\_\_\_\_ R. \_\_\_\_\_
- 3. Miscellaneous S. \_\_\_\_\_ T. \_\_\_\_\_ R. \_\_\_\_\_  
Property in Section S. \_\_\_\_\_ T. \_\_\_\_\_ R. \_\_\_\_\_
- 4. Lot No. \_\_\_\_\_, Recorded Plat \_\_\_\_\_
- 5. Private Claims \_\_\_\_\_

199900009776  
Filed for Record in  
CLARE COUNTY MICHIGAN  
CAROL MCAULAY  
On 11-10-1999 At 01:30 pm.  
LAND CORNER 9.00  
OR Liber 2 Page 55 - 55

Instrument Liber Page  
199900009776 OR 2 55

# 366-99

Register of Deeds Stamp & File Number

I, Mark R. Robison, in a field survey on July 21, 1999, do hereby certify that under requirements of P.A. 74, Michigan P.A. of 1970, the corner points mentioned in lines 1 and 2 above were in conformance with regulations and rules therefore as required in the current manual of survey instructions of the United States Department of the Interior, Bureau of Land Management or by a decree of a Court of Law and/or that the corner points mentioned in lines 3, 4 and 5 above were in conformance with the rules of the Michigan Board of Land Surveyors or by a Decree of a Court of Law, established, re-established, monumented, re-monumented, recovered, found as expressed below.

	A	B	C	D	E	F	G	H	I	J	K	L	M
2	6	5	4	3	2	1							
3													
4	7	8	9	10	11	12							
5													
6	18	17	16	15	14	13							
7													
8	19	20	21	22	23	24							
9													
10	30	29	28	27	26	25							
11													
12	31	32	33	34	35	36							
13													

NOTE: Not more than 2 corners, all in the same town and range, may be recorded on this certificate.

A. Description of original monument and accessories and/or subsequent restoration:

1837 Hodson  
79.94 Sec. Cor.  
Beech 15" Corner  
Maple 20 N55W 12

Circa 1900 Unknown, C.S.R. 6-16, 6-17;  
Iron Pipe  
Tel. Pole 10" N41E 58  
Fence Post 6" S29 1/2 W 40

4-05-73 Sedgman, LCRC, 94  
Fd 3/4" rod in Mon. Box  
N33W 80.47 P.P.  
N05E 59.41 R/W Marker  
S02W 60.53 R/W Marker

Circa 1965 M.S.H.D., U.S. 10 R-W Plans 18024  
Fd 3/4" rod in Mon. Box in line w/fence N & S.  
Meas. East 2638.15 to F-7  
Meas. North 2632.79 to E-6  
N33W 80.47 P.P.  
N05E 59.41 R/W Marker  
S02W 60.53 R/W Marker

10-04-73 Urbaniak, (132) 1-578  
Refer to LCRC, 94

6-21-76 Lapham, LCRC, 238  
Same as LCRC, 94

B. Description of corner evidence found and/or method applied in restoring or re-establishing corner:  
See dossier for detailed report.

Fd 1/2" x 18" iron in Mon. Box. Fd one 1965 witness Meas. East 5276.74' (MSHD 5276.30) to G-7


C. Description of monument for corner and accessories established to perpetuate locating the position of the corner  
Set 5/8" x 36" re-rod with Clare Co. Remon Cap marked P.S. #27458 in existing Mon. Box in abandoned road bed. Accepted as best available evidence of the accepted position of the corner.

Witnesses:  
N13°E 44.52 Set N & T in 2" W. Pine  
S33°E 76.83 Set N & T in 6" W. Pine  
South 60.41 Top Cen. of conc. R/W Marker (OBT)  
N44°W 50.80 Set N & T in P.P.  
North 110' C.L. pvm't

APPROVED LAND CORNER  
P.A. 345 of 1990  
Clare County

Chairman Paul B. Lapham  
Date 9-29-99

Signed by Mark R. Robison  
Surveyor's Michigan License No. 27458

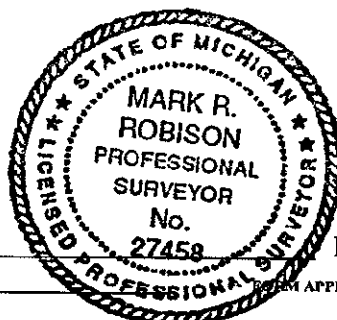

Date 11-8-99