

SURVEY & REMONUMENTATION

MAR 24 2000 LAND CORNER RECORDATION CERTIFICATE

Filing Requirement of Act 74, Mich. P.A. 1970

SECTION Clare County Remonumentation

For Corners in

Clare

(County)

Located In:

Corner Code#:

- 1. Public Land Survey T. 17N R. 5W F-7
 T. _____ R. _____
 T. _____ R. _____
- 2. Public Controlling S. _____ T. _____ R. _____
 in Section S. _____ T. _____ R. _____
- 3. Miscellaneous S. _____ T. _____ R. _____
 Property in Section S. _____ T. _____ R. _____
- 4. Lot No. _____, Recorded Plat _____
- 5. Private Claims _____

199900009778
 Filed for Record in
 CLARE COUNTY MICHIGAN
 CAROL MCAULAY
 On 11-10-1999 At 01:30 pm.
 LAND CORNER 9.00
 OR Liber 2 Page 57 - 57

Instrument 199900009778 OR Liber Page 2 57

368-99

Register of Deeds Stamp & File Number

I, Mark R. Robison, in a field survey on July 7, 1999, do hereby certify that under requirements of P.A. 74, Michigan P.A. of 1970, the corner points mentioned in lines 1 and 2 above were in conformance with regulations and rules therefore as required in the current manual of survey instructions of the United States Department of the Interior, Bureau of Land Management or by a decree of a Court of Law and/or that the corner points mentioned in lines 3, 4 and 5 above were in conformance with the rules of the Michigan Board of Land Surveyors or by a Decree of a Court of Law, established, re-established, monumented, re-monumented, recovered, found as expressed below.

NOTE: Not more than 2 corners, all in the same town and range, may be recorded on this certificate.

	A	B	C	D	E	F	G	H	I	J	K	L	M
1													
2	6	5	4	3	2	1							
3													
4	7	8	9	10	11	12							
5													
6	18	17	16	15	14	13							
7													
8	19	20	21	22	23	24							
9													
10	30	29	28	27	26	25							
11													
12	31	32	33	34	35	36							
13													

A. Description of original monument and accessories and/or subsequent restoration:

1837 Nicholson
 Set 1/4 Sec. Post
 Beech 10 S53E 10
 Beech 6 S67W 18

Circa 1900, C.S.R. 6-16, 6-21:
 Tel. Pole 8 N58W 70
 Tel. Pole 9 N78 1/4 E 169

3-20-73 Fluharty, L-14, P.11
 Plat of Elm Creek Estates
 F-7 is P.O.B. (Mon 75' North)

11-10-77 Lapham, LCRC #306
 Same as 3-18-77 survey

Circa 1965 M.S.H.D., U.S. 10 R/W Plan #18024
 No Corner Set.
 Established Position S.P.M. between
 E-7 & G-7. Meas. 2638.15 both ways

3-18-77 Lapham, Unrec. Survey
 Found P.K. nail
 North 61.70 Fence Cor.
 South 0.4 old centerline road
 S40W 75.35 P.P.
 S30E 56.80 Guard Post

5-02-78 Lapham, Unrec. Survey
 Same as 3-18-77 survey

11-26-93 Lapham
 Same as 3-18-77 survey


B. Description of corner evidence found and/or method applied in restoring or re-establishing corner:
 See dossier for detailed report.

Found no evidence of corner material in pvm't. Established position at S.P.M. between E-7 & G-7. Corner falls 0.5 feet N. of. C.L. asphalt pvm't and 2638.37 feet (MSHD 2638.15) from E-7 & G-7. Fd Conc. Mon 75.0 feet north.

C. Description of monument for corner and accessories established to perpetuate locating the position of the corner:

Set 5/8" x 36" re-rod with Clare Co. Remon Cap. marked P.S. #27458 in Mon. Box. Position is accepted method of re-establishment of the corner.

Witnesses:
 N58°E 175.95 Center of 12" Silver Maple
 S49°E 135.25 Center of 11" Red King Maple
 S17°E 76.39 N & T in 14" Pine
 S30°W 69.73 Nail in conc. R/W marker
 North 75.00 Conc. Mon.

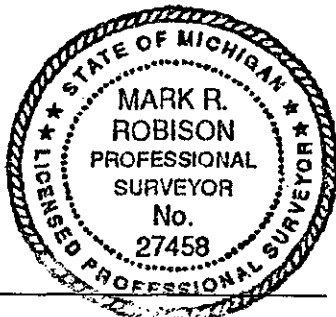

APPROVED LAND CORNER
 P.A. 345 of 1990
 Clare County

Chairman Paul B. Lapham
 Date 9-29-99

Signed by Mark R. Robison
 Surveyor's Michigan License No. 27458

Date 11-8-99