

**SURVEY & REMONUMENTATION**

**JAN 23 2001**

**LAND CORNER RECORDATION CERTIFICATE**

Filing Requirement of Act 74, Mich. PA 1970

CLARE COUNTY REMONUMENTATION

**SECTION**

For Corners In:

Clare (County)	Located In	Corner Code #
1. Public Land Survey	T 17N R 5W	F11
2. Property Controlling in Section	S T R	
3. Miscellaneous Property in Section	S T R	

4. Lot No: \_\_\_\_\_ Recorded Plat: \_\_\_\_\_

5. Private Claims: \_\_\_\_\_


I, Craig W. McVean, in a field survey on July 20, 2000 do hereby state that under requirements of PA 74, Michigan PA of 1970, the corner points mentioned in lines 1 and 2 above were in conformance with regulations and rules therefore as required in the current manual of survey instructions of the United States Department of the Interior, Bureau of Land Management or by a decree of a Court of Law and/or that the corner points mentioned in lines 3, 4 and 5 above were in conformance with the rules of the Michigan Board of Land Surveyors or by a Decree of a Court of Law; established, re-established, monumented, recovered, found as expressed below:

**NOTE: Not more than 2 corners, all in the same town and range, may be recorded on this certificate.**

20000009709  
 Filed for Record in  
 CLARE COUNTY MICHIGAN  
 CAROL MCAULAY  
 On 11-29-2000 At 12:12 PM.  
 LAND CORNER 9.00  
 OR Liber 2 Page 238 - 238

Instrument Liber Page  
 20000009709 OR 2 238  
 #443-00

Register of Deeds Stamp & File Number

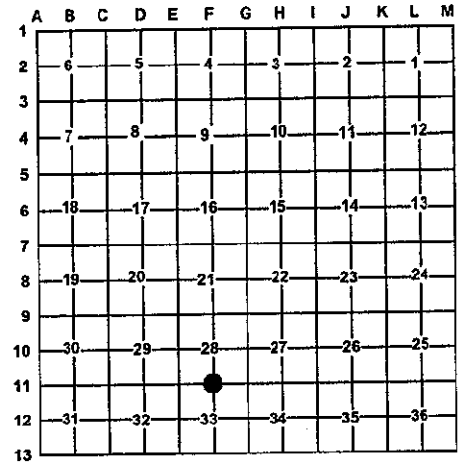

**A. Description of original monument and accessories and/or subsequent restoration:**

- F11-GLO- Set 1/4 post-H. Nicholson-1837  
 Cedar 8" S62°W 19 L.  
 Hemlock 6" N56°E 39 L.
- CSR-Bk.6, P.33-Cedar 4" N72°W 16 L.
- Cedar 3" S50°W 22 1/2 L.

**APPROVED LAND CORNER**  
 P.A. 345 of 1990  
 Clare County  
 Chairman Paul B. Lophm  
 Date 10-23-2000

**B. Description of corner evidence found and/or method applies in restoring or re-establishing corner:**  
 F11-1/4 corner common to Sec. 28 & 33-Could find no evidence of GLO or Co. Survey Record BT's. All Cedar & other trees in swamp were cut 10 years + ago. Set 4" DNR Alum. Cap on 1" x 5' long galv. Iron pipe at Single Proportional position on line between E11 & G11. DNR Mon. accepted a careful & faithful re-establishment of the position of the original corner.

**C. Description of monument for corner and accessories established to perpetuate locating the position of the corner:**

- F11-DNR Monument  
 Set Blue Carsonite Post 1"N  
 East 55.75' to N&T in S side 26" WPS scribed 'XBT'  
 S52°E 37.16' to N&T in SW side 4" Fir scribed 'XBT'  
 S36°W 20.05' to N&T in NW side 3" Fir scribed 'XBT'  
 N3°E 5.23' to N&T in W side 4" Fir scribed 'XBT'

DNR Mon. used & accepted in place of Clare Co. Remon. Mon.



Signed by: Craig W. McVean  
 Surveyor's Michigan License No.: 39088

Date: 10/18/2000