

SURVEY &  
REMONUMENTATION

MAR 24 2000

LAND CORNER RECORDATION CERTIFICATE  
Filing Requirement of Act 74, Mich. P.A. 1970  
Clare County Remonumentation

SECTION

For Corners in  
Clare  
(County)

Located In: Corner Code#:

1. Public Land Survey T. 17N R. 5W G-5  
T. \_\_\_\_\_ R. \_\_\_\_\_  
T. \_\_\_\_\_ R. \_\_\_\_\_

2. Public Controlling S. \_\_\_\_\_ T. \_\_\_\_\_ R. \_\_\_\_\_  
in Section S. \_\_\_\_\_ T. \_\_\_\_\_ R. \_\_\_\_\_

3. Miscellaneous S. \_\_\_\_\_ T. \_\_\_\_\_ R. \_\_\_\_\_  
Property in Section S. \_\_\_\_\_ T. \_\_\_\_\_ R. \_\_\_\_\_

4. Lot No. \_\_\_\_\_, Recorded Plat \_\_\_\_\_

5. Private Claims \_\_\_\_\_

199900009785  
Filed for Record in  
CLARE COUNTY MICHIGAN  
CAROL MCAULAY  
On 11-10-1999 At 01:30 pm.  
LAND CORNER 9.00  
OR Liber 2 Page 64 - 64

Instrument Liber Page  
199900009785 OR 2 64

# 375-99

Register of Deeds Stamp & File Number

I, Mark R. Robison, in a field survey on June 30, 1999, do hereby certify that under requirements of P.A. 74, Michigan P.A. of 1970, the corner points mentioned in lines 1 and 2 above were in conformance with regulations and rules therefore as required in the current manual of survey instructions of the United States Department of the Interior, Bureau of Land Management or by a decree of a Court of Law and/or that the corner points mentioned in lines 3, 4 and 5 above were in conformance with the rules of the Michigan Board of Land Surveyors or by a Decree of a Court of Law, established, re-established, monumented, re-monumented, recovered, found as expressed below.

NOTE: Not more than 2 corners, all in the same town and range, may be recorded on this certificate.

	A	B	C	D	E	F	G	H	I	J	K	L	M
1													
2	6	5	4	3	2	1							
3													
4	7	8	9	10	11	12							
5													
6	18	17	16	15	14	13							
7													
8	19	20	21	22	23	24							
9													
10	30	29	28	27	26	25							
11													
12	31	32	33	34	35	36							
13													

A. Description of original monument and accessories and/or subsequent restoration:

1837 Nicholson  
Set Post Cor Sec. 9-10-15-16  
Cedar 6" S66W 15  
Cedar 8" N27E 17

Circa 1900 Unknown  
CSR Bk. 6 Pg. 9-10-15-16  
B. Ash 18 S47 1/2 W 20 1/2  
Cedar 6 S62W 15

1982 Lapham, (132) 2-759  
Found Sucker Rod  
N60E 55.00 P. Pole  
N70W 20.3 Gas Line Marker  
N05E 139.4 Bridge Headwell  
Meas. South 2640.80

1970 MSHD, Project #18024  
Fd 3/4" bolt in line w/fence E & 3' E  
of center N-S Road.  
N27E 53.77 4" Maple  
N53E 53.23 P. Pole  
Due E 33.30 F. Post  
S47E 46.34 4" S. Alder  
Meas. South 2638.90

1982 Robison, (132) 2-744  
Same as (132) 2-759

B. Description of corner evidence found and/or method applied in restoring or re-establishing corner:  
See dossier for detailed report.


Found 1" x 24" sq. iron bar threaded on one end (Axel rod) 14 inches below gravel surface of newly constructed road. Existing P.P. fit one 1982 witness. All other witnesses have been removed. Meas. South 2640.62 (PBL 2640.80 and MDOT 2638.90) to G-6.

C. Description of monument for corner and accessories established to perpetuate locating the position of the corner:

Set 5/8" x 36" rerod with Clare Co. Remon Cap marked P.S. #27458. Accepted as best available evidence of the accepted position of the corner.

Witnesses:  
N13°E 136.56 Notch in top cen. East end 48" CMP  
N55°E 55.01 N & T in P.P. (OBT)  
East 33.00 C.I. (Mid Mich Engr)  
N10°W 147.23 Notch in top cen. West end 48" CMP

Signed by Mark R. Robison  
Surveyor's Michigan License No. 27458

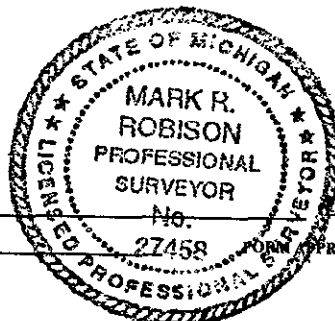

APPROVED LAND CORNER  
P.A. 945 of 1990  
Clare County

Chairman Paul S. Laska  
Date 9-29-99

Date 11-8-99

APPROVED BY MICHIGAN STATE BOARD OF LAND SURVEYORS, JAN. 28, 1971

REVISED MAY 14, 1975  
REVISED JAN., 1983