

SECTION

LAND CORNER RECORDATION CERTIFICATE
Filing Requirement of Act 74, Mich. P.A. 1970
Clare County Remonumentation

For Corners in
Clare

(County)

Located In:

Corner Code#:

- 1. Public Land Survey T. 17N R. 5W G-6
2. Public Controlling in Section S. T. R.
3. Miscellaneous Property in Section S. T. R.
4. Lot No., Recorded Plat
5. Private Claims

199900009790
Filed for Record in
CLARE COUNTY MICHIGAN
CAROL MCAULAY
On 11-10-1999 At 01:30 pm.
LAND CORNER 9.00
OR Liber 2 Page 69 - 69

Instrument 199900009790 OR Liber 2 Page 69

380-99

Register of Deeds Stamp & File Number

I, Mark R. Robison, in a field survey on July 30, 1999, do hereby certify that under requirements of P.A. 74, Michigan P.A. of 1970, the corner points mentioned in lines 1 and 2 above were in conformance with regulations and rules therefore as required in the current manual of survey instructions of the United States Department of the Interior, Bureau of Land Management or by a decree of a Court of Law and/or that the corner points mentioned in lines 3, 4 and 5 above were in conformance with the rules of the Michigan Board of Land Surveyors or by a Decree of a Court of Law, established, re-established, monumented, re-monumented, recovered, found as expressed below.

Grid table with columns A-M and rows 1-13 containing numbers 1-36.

NOTE: Not more than 2 corners, all in the same town and range, may be recorded on this certificate.

A. Description of original monument and accessories and/or subsequent restoration:

1837 Nicholson
40.00 Cedar 10" qr. Sec. Post

Circa 1900, CSR 6-15, 6-16
Tyle Cinders & Stake
Fence Post N30W 43 1/2

1972 Verba LCRC #67
Fd 1/2" Iron 63.98' North of
C.L. of M-115 & on C.L. Harding Rd.
N48W 123.20 MSHD Tag in 15" B. Cherry
N18E 79.01 MSHD Tag in 6" Poplar
S21W 116.72 MSHD Tag in side T. P.

1987 Robison, (132) 3-4
Fd 1/2" C.I.
Same witnesses as LCRC #383

1949 Johnson, CSR 3-2 & 2-161
References 15-16 1/4 Corner in
survey of parcel of land

1980 Lapham LCRC #383& (132) 2-759
Set 1/2" C.I. from Hwy. Data
N80W 18.8 East face Conc. Pillar
S45W 36.8 Edge Conc. Road
S70E 72.65 4" Pipe, Gas Line Marker
Meas. N, 2640.80

1970 MSHD, Project #18024
Fd 1/2" rod
N48W 123.20 15" B. Cherry
N18E 79.01 6" Poplar
S42W 38.10 N. Edge M- 115
S21W 116.72 T. Pole
Meas. N 2638.90 & S 2638.90

B. Description of corner evidence found and/or method applied in restoring or re-establishing corner:

See dossier for detailed report.

Fd 1/2" x 18" rered and two 1980 witnesses in side of overpass embankment. All other witnesses removed by Hwy. construction. Meas. North 2640.62 (MSHD 2638.90) to G-5. Meas. South 2637.60 (MSHD 2637.25) to G-7. Meas. East approx. 5260 via. G.P.S. (MSHD 5257.87).


C. Description of monument for corner and accessories established to perpetuate locating the position of the corner:

Set 5/8" x 36" rered with Clare Co. Remon Cap marked P.S. #27458. Accepted as best available evidence of the accepted position of the corner.

Witnesses:

- N50°W 18.80 East face of Concrete Pillar (OBT)
N60°E 35.50 S.E. corner of retaining headwall
S40°W 48.69 C.L. US-10 (BR) & M-115
S01° 20' 56" (MSHD) 2637.60 to G-7

Signed by [Signature]
Surveyor's Michigan License No. 27458

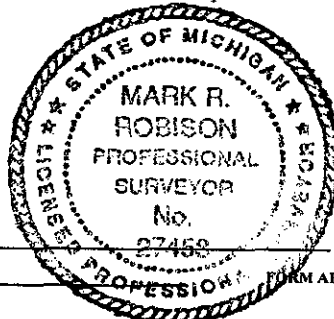

APPROVED LAND CORNER
P.A. 345 of 1990
Clare County

Chairman [Signature]

Date 9-29-99

Date 11-8-99